

309093

WELL CONSTRUCTION RECORD

WELL CONTRACTOR: Dewey Wright Well Pump Co., Inc.
 WELL CONTRACTOR CERTIFICATION #: 2686
 STATE WELL CONSTRUCTION PERMIT#: Leslie Reece

050044

1. WELL USE (Check Applicable Box): Residential Municipal Industrial Agricultural Monitoring
 Recovery Heat Pump Water Injection Other If Other, List Use: _____

2. WELL LOCATION: (Show sketch of the location below)
 Nearest Town: LINVILLE County: AVERY
BLUMING WAY OFF BAUMDORF OFF ALPEN WAY OFF
(Road Name and Numbers, Community, or Subdivision and Lot No.)

DRILLING LOG		DEPTH
From	To	Formation Description
0	126	DIRT SAND
126	183	GRANITE
183	184	SHALE
184	222	GRANITE
222	224	SHALE
224	240	GRANITE

MUD BY CONTRACTOR
MAR 24 05

3. DATE DRILLED 2/2/2005
 4. TOTAL DEPTH 240
 6. CUTTINGS COLLECTED YES NO
 7. DOES WELL REPLACE EXISTING WELL? YES NO
 8. STATIC WATER LEVEL Below Top of Casing: 80 FT.
(Use "+" if Above Top of Casing)

9. TOP OF CASING IS 1 FT. Above Land Surface*
*Top of casing terminated at/or below land surface requires a variance in accordance with 15A NCAC 2C.0118

10. YIELD (gpm): 40 METHOD OF TEST Air
 11. WATER ZONES (depth): 10.00 gpm 183-184 30.00 gpm 222-224
0.00 gpm 0.00 gpm
 12. CHLORINATION: Type HTH Amount 32


If additional space is needed use back of form

13. CASING:

From	To	Depth	Diameter	Wall Thickness or Weight/Ft.	Material
0	133	Ft.	6 1/8	.350	PVC
From	To	Ft.			
From	To	Ft.			

LOCATION SKETCH

(Show direction and distance from at least two State Roads, or other map reference points)

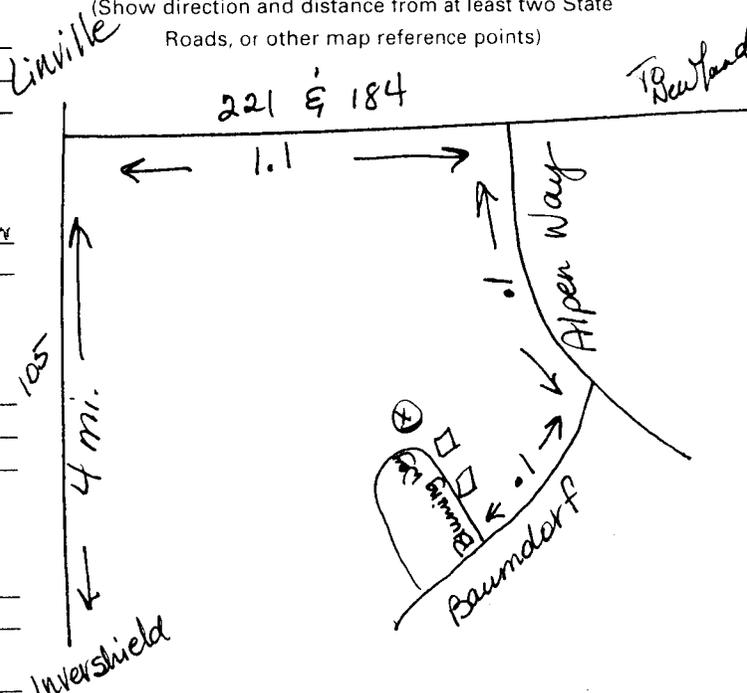

14. GROUT:

From	To	Depth	Material	Method
0	20	Ft.	Cement	Gravity Flow
From	To	Ft.		

15. SCREEN:

From	To	Depth	Diameter	Slot Size	Material
From	To	Ft.	in.	in.	
From	To	Ft.	in.	in.	
From	To	Ft.	in.	in.	

16. SAND/GRAVEL PACK:

From	To	Depth	Size	Material
From	To	Ft.		
From	To	Ft.		

17. REMARKS: _____
 I DO HEREBY CERTIFY THAT THIS WELL WAS CONSTRUCTED IN ACCORDANCE WITH 15A NCAC 2C, WELL CONSTRUCTION STANDARDS, AND THAT A COPY OF THIS RECORD HAS BEEN PROVIDED TO THE WELL OWNER.

Wayne Reece

2-18-05

FOR OFFICE USE ONLY
 Quad No: _____
 Serial No: _____

SIGNATURE OF PERSON CONSTRUCTING THE WELL _____ DATE _____
 Submit original to Division of Water Quality, Groundwater Section within 30 days
 GW-1 REV. 12/99