

309095

WELL CONSTRUCTION RECORD

WELL CONTRACTOR: Dewey Wright Well Pump Co., Inc
 WELL CONTRACTOR CERTIFICATION #: 2688
 STATE WELL CONSTRUCTION PERMIT#: Leslie Reece

050030

1. WELL USE (Check Applicable Box): Residential Municipal Industrial Agricultural Monitoring
 Recovery Heat Pump Water Injection Other If Other, List Use: _____

2. WELL LOCATION: (Show sketch of the location below)
 Nearest Town: PINEOLA County: AVERY
LOT # 12 COUGAR RUN RD OFF BEAR CREEK RD OFF
(Road Name and Numbers, Community, or Subdivision and Lot No.)

3. DATE DRILLED 1/27/2005
 4. TOTAL DEPTH 300
 6. CUTTINGS COLLECTED YES NO
 7. DOES WELL REPLACE EXISTING WELL? YES NO
 8. STATIC WATER LEVEL Below Top of Casing: 100 FT.
(Use "+" if Above Top of Casing)

DRILLING LOG		DEPTH
From	To	Formation Description
0	160	DIRT SAND
160	201	GRANITE
201	202	SHALE
202	245	GRANITE
245	248	SHALE
248	300	GRANITE


RECORDED BY DIGITAL FILE
MAR 24 05

If additional space is needed use back of form

9. TOP OF CASING IS 1 FT. Above Land Surface*
*Top of casing terminated at/or below land surface requires a variance in accordance with 15A NCAC 2C.0118
 10. YIELD (gpm): 25 METHOD OF TEST Air
 11. WATER ZONES (depth): 4.00 gpm 201-202 21.00 gpm 245-248
0.00 gpm 0.00 gpm
 12. CHLORINATION: Type HTH Amount 41

13. CASING:

From	Depth	To	Diameter	Wall Thickness or Weight/Ft.	Material
0		166 Ft.	6 1/8	350	PVC
From	To	Ft.			
From	To	Ft.			

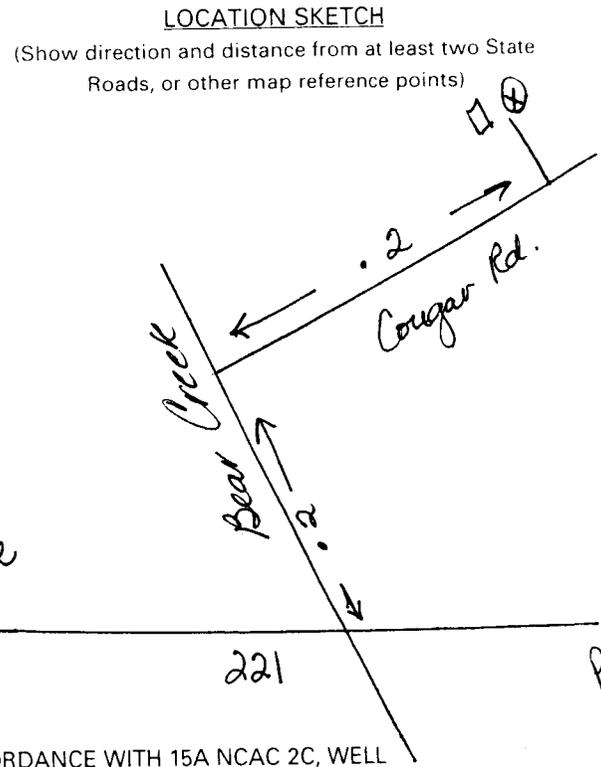

14. GROUT:

From	Depth	To	Material	Method
0		20 Ft.	Cement	Gravity Flow
From	To	Ft.		

15. SCREEN:

From	Depth	To	Ft.	Diameter	Slot Size	Material
From	To	Ft.		in.	in.	
From	To	Ft.		in.	in.	
From	To	Ft.		in.	in.	

16. SAND/GRAVEL PACK:

From	Depth	To	Ft.	Size	Material
From	To	Ft.			
From	To	Ft.			

17. REMARKS: _____
 I DO HEREBY CERTIFY THAT THIS WELL WAS CONSTRUCTED IN ACCORDANCE WITH 15A NCAC 2C, WELL CONSTRUCTION STANDARDS, AND THAT A COPY OF THIS RECORD HAS BEEN PROVIDED TO THE WELL OWNER.

Wayne Reece 2-18-05
 SIGNATURE OF PERSON CONSTRUCTING THE WELL DATE
 Submit original to Division of Water Quality, Groundwater Section within 30 days
 GW-1 REV. 12/99

FOR OFFICE USE ONLY
 Quad No: _____