

WELL CONSTRUCTION RECORD

WELL CONTRACTOR: Dewey Wright Well Pump Co., Inc.
 WELL CONTRACTOR CERTIFICATION #: 2791
 STATE WELL CONSTRUCTION PERMIT#: Albert Slate

050032

1. WELL USE (Check Applicable Box): Residential Municipal Industrial Agricultural Monitoring
 Recovery Heat Pump Water Injection Other If Other, List Use: _____

2. WELL LOCATION: (Show sketch of the location below)
 Nearest Town: BANNER ELK County: AVERY
LOT 27-28-29 IN ELK RIVER OFF HWY 194
(Road Name and Numbers, Community, or Subdivision and Lot No.)

3. DATE DRILLED 1/27/2005
 4. TOTAL DEPTH 400
 5. CUTTINGS COLLECTED YES NO
 6. DOES WELL REPLACE EXISTING WELL? YES NO
 7. STATIC WATER LEVEL Below Top of Casing: 100 FT.
(Use "+" if Above Top of Casing)


DRILLING LOG		DEPTH
From	To	Formation Description
0	45	DIRT
45	175	LIMESTONE
175	176	CREVICE
176	295	LIMESTONE
295	296	CREVICE
296	310	LIMESTONE
310	355	GRANITE
355	356	CREVICE
356	400	GRANITE

RECD BY CENTRAL TND
MAR 24 0

8. TOP OF CASING IS 1 FT. Above Land Surface*
*Top of casing terminated at/or below land surface requires a variance in accordance with 15A NCAC 2C.0118
 9. YIELD (gpm): 100 METHOD OF TEST Air
 10. WATER ZONES (depth): 7.00 gpm 175-176 8.00 gpm 295-296
85.00 gpm 355-356 0.00 gpm
 11. CHLORINATION: Type HTH Amount 60

12. CASING:
 Depth Diameter Wall Thickness or Weight/Ft. Material
 From 0 To 92 Ft. 6 1/8 350 PVC
 From _____ To _____ Ft. _____ _____ _____
 From _____ To _____ Ft. _____ _____ _____

13. LOCATION SKETCH
 (Show direction and distance from at least two State Roads, or other map reference points)

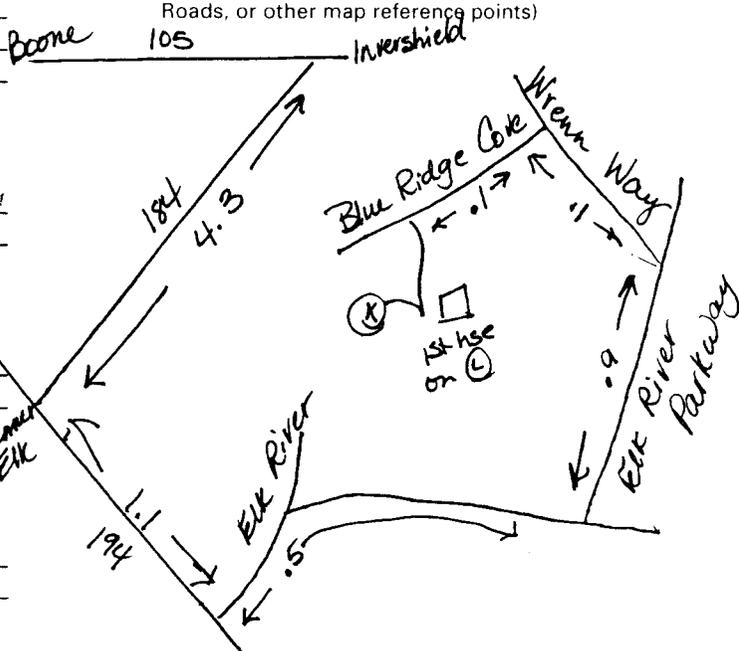

14. GROUT:
 Depth Material Method
 From 0 To 20 Ft. Cement Gravity Flow
 From _____ To _____ Ft. _____ _____

15. SCREEN:
 Depth Diameter Slot Size Material
 From _____ To _____ Ft. _____ in. _____ in. _____
 From _____ To _____ Ft. _____ in. _____ in. _____
 From _____ To _____ Ft. _____ in. _____ in. _____

16. SAND/GRAVEL PACK:
 Depth Size Material
 From _____ To _____ Ft. _____ _____
 From _____ To _____ Ft. _____ _____

17. REMARKS:
 I DO HEREBY CERTIFY THAT THIS WELL WAS CONSTRUCTED IN ACCORDANCE WITH 15A NCAC 2C, WELL CONSTRUCTION STANDARDS, AND THAT A COPY OF THIS RECORD HAS BEEN PROVIDED TO THE WELL OWNER.

Albert Slate 2-17-05
 SIGNATURE OF PERSON CONSTRUCTING THE WELL DATE

FOR OFFICE USE ONLY
 Quad No: _____
 Serial No: _____