

OK

310853

WELL CONSTRUCTION RECORD

WELL CONTRACTOR: Dewey Wright Well Pump Co., Inc.
 WELL CONTRACTOR CERTIFICATION #: 2886
 STATE WELL CONSTRUCTION PERMIT#: Leslie Reece

050080

1. WELL USE (Check Applicable Box): Residential Municipal Industrial Agricultural Monitoring
 Recovery Heat Pump Water Injection Other If Other, List Use: _____

2. WELL LOCATION: (Show sketch of the location below)
 Nearest Town: BANNER FLK County: AVERY
HICKORY NUT GAP RD OFF 184 OFF 105
(Road Name and Numbers, Community, or Subdivision and Lot No.)

3. DRILLING LOG
- | From | To | Formation Description |
|------|-----|-----------------------|
| 0 | 82 | DIRT |
| 82 | 97 | GRANITE |
| 97 | 98 | SHALE |
| 98 | 175 | GRANITE |
| 175 | 176 | SHALE |
| 176 | 205 | GRANITE |
4. DATE DRILLED 3/14/2005
 5. TOTAL DEPTH 205
 6. CUTTINGS COLLECTED YES NO
 7. DOES WELL REPLACE EXISTING WELL? YES NO
 8. STATIC WATER LEVEL Below Top of Casing: 50 FT.
(Use "+" if Above Top of Casing)

DRILLING LOG	DEPTH	
From	To	Formation Description
0	82	DIRT
82	97	GRANITE
97	98	SHALE
98	175	GRANITE
175	176	SHALE
176	205	GRANITE

MAY 13 05
 RECORD OF DEPTH

If additional space is needed use back of form

9. TOP OF CASING IS 1 FT. Above Land Surface*
*Top of casing terminated at/or below land surface requires a variance in accordance with 15A NCAC 2C.0118
 10. YIELD (gpm): 10 METHOD OF TEST Air
 11. WATER ZONES (depth): 3.00 gpm 97-98 7.00 gpm 175-176
0.00 gpm 0.00 gpm
 12. CHLORINATION: Type HTH Amount 31


13. CASING:
- | Depth | Diameter | Wall Thickness or Weight/Ft. | Material |
|--------------------------------|--------------|------------------------------|------------|
| From <u>0</u> To <u>86</u> Ft. | <u>6 1/8</u> | <u>350</u> | <u>PVC</u> |
| From _____ To _____ Ft. | _____ | _____ | _____ |
| From _____ To _____ Ft. | _____ | _____ | _____ |

14. GROUT:
- | Depth | Material | Method |
|--------------------------------|---------------|---------------------|
| From <u>0</u> To <u>20</u> Ft. | <u>Cement</u> | <u>Gravity Flow</u> |
| From _____ To _____ Ft. | _____ | _____ |

15. SCREEN:
- | Depth | Diameter | Slot Size | Material |
|-------------------------|-----------|-----------|----------|
| From _____ To _____ Ft. | _____ in. | _____ in. | _____ |
| From _____ To _____ Ft. | _____ in. | _____ in. | _____ |
| From _____ To _____ Ft. | _____ in. | _____ in. | _____ |

16. SAND/GRAVEL PACK:
- | Depth | Size | Material |
|-------------------------|-------|----------|
| From _____ To _____ Ft. | _____ | _____ |
| From _____ To _____ Ft. | _____ | _____ |

17. REMARKS: _____
 I DO HEREBY CERTIFY THAT THIS WELL WAS CONSTRUCTED IN ACCORDANCE WITH 15A NCAC 2C, WELL CONSTRUCTION STANDARDS, AND THAT A COPY OF THIS RECORD HAS BEEN PROVIDED TO THE WELL OWNER.

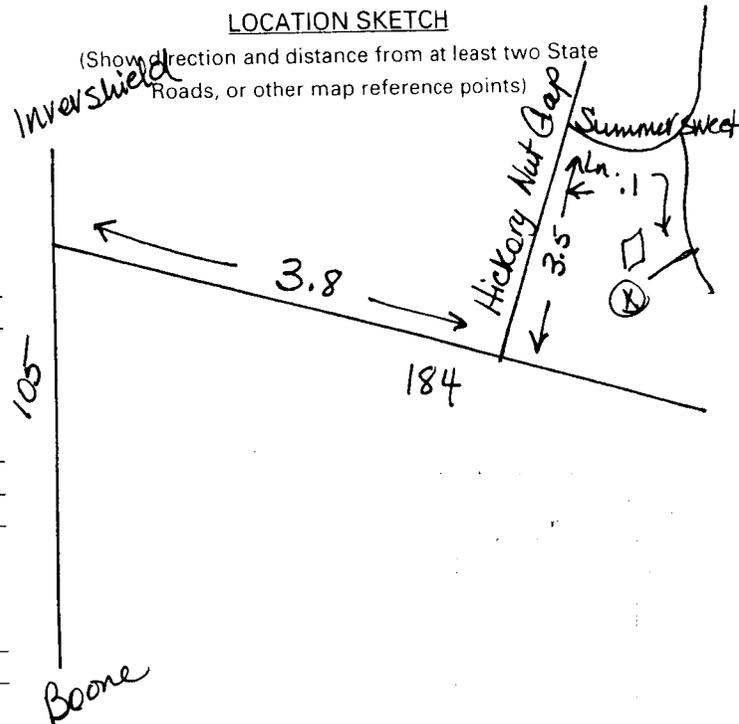

FOR OFFICE USE ONLY
 Quad No: _____

Wayne Reece 4-8-05
 SIGNATURE OF PERSON CONSTRUCTING THE WELL DATE