

311000

WELL CONSTRUCTION RECORD

WELL CONTRACTOR: Dewey Wright Well Pump Co. Inc
 WELL CONTRACTOR CERTIFICATION #: 2686
 STATE WELL CONSTRUCTION PERMIT#: Leslie Reece

050137

1. WELL USE (Check Applicable Box): Residential Municipal Industrial Agricultural Monitoring
 Recovery Heat Pump Water Injection Other If Other, List Use: _____

2. WELL LOCATION: (Show sketch of the location below)
 Nearest Town: BANNER ELK County: SWAYNE
CHARLIE ELLER RD. OFF OLD BEECHMOUNT RD. OFF HWY
(Road Name and Numbers, Community, or Subdivision and Lot No.)

3. _____
 4. DATE DRILLED 1/8/2005
 5. TOTAL DEPTH 120
 6. CUTTINGS COLLECTED YES NO
 7. DOES WELL REPLACE EXISTING WELL? YES NO
 8. STATIC WATER LEVEL Below Top of Casing: 30 FT.
(Use "+" if Above Top of Casing)

DRILLING LOG		DEPTH
From	To	Formation/Description
0	17	MUDSTONE
17	61	GRANITE
61	62	SHALE
62	88	GRANITE
88	99	SHALE
99	120	GRANITE

JUN - 2 05

9. TOP OF CASING IS 1 FT. Above Land Surface*
*Top of casing terminated at/or below land surface requires a variance in accordance with 15A NCAC 2C.0118
 10. YIELD (gpm): 40 METHOD OF TEST Air
 11. WATER ZONES (depth): 2-00 gpm 01-82 32-00 gpm 98-99
0-00 gpm 0-00 gpm
 12. CHLORINATION: Type HTH Amount 12

13. CASING:

From	To	Depth	Diameter	Wall Thickness or Weight/Ft.	Material
0	21	Ft.	8 1/2	1.98	SAW
21	120	Ft.			

14. GROUT:

From	To	Depth	Material	Method
0	21	Ft.	Cement	Gravity Flow

15. SCREEN:


From	To	Depth	Diameter	Slot Size	Material
		Ft.	in.	in.	

16. SAND/GRAVEL PACK:

From	To	Depth	Size	Material
		Ft.		

17. REMARKS: _____
 I DO HEREBY CERTIFY THAT THIS WELL WAS CONSTRUCTED IN ACCORDANCE WITH 15A NCAC 2C, WELL CONSTRUCTION STANDARDS, AND THAT A COPY OF THIS RECORD HAS BEEN PROVIDED TO THE WELL OWNER.

LOCATION SKETCH
 (Show direction and distance from at least two State Roads, or other map reference points)

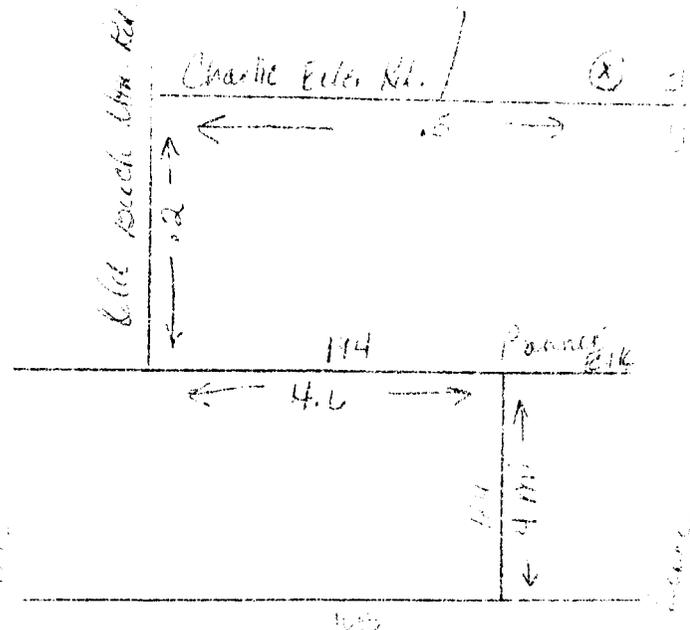

FOR OFFICE USE ONLY
 Quad No: _____
 Serial No. _____

Leslie Wayne Reece 4-26-05
 SIGNATURE OF PERSON CONSTRUCTING THE WELL DATE
 Submit original to Division of Water Quality, Groundwater Section within 30 days