

AWC

WELL CONSTRUCTION RECORD

WELL CONTRACTOR: Dewey Wright Well Pump Co. Inc.
 WELL CONTRACTOR CERTIFICATION #: 2891
 STATE WELL CONSTRUCTION PERMIT#: Steve Petry

050067

1. WELL USE (Check Applicable Box): Residential Municipal Industrial Agricultural Monitoring
 Recovery Heat Pump Water Injection Other If Other, List Use: _____

2. WELL LOCATION: (Show sketch of the location below)
 Nearest Town: INVERSHIELD County: DAVIE
DREAM CATCHERS OFF CURTIS CREEK RD OFF 104 OFF
(Road Name and Numbers, Community, or Subdivision and Lot No.)

3. _____
 4. DATE DRILLED 1/19/2005
 5. TOTAL DEPTH 125
 6. CUTTINGS COLLECTED YES NO
 7. DOES WELL REPLACE EXISTING WELL? YES NO
 8. STATIC WATER LEVEL Below Top of Casing: 20 FT.
(Use "+" if Above Top of Casing)

DRILLING LOG		DEPTH
From	To	Formation Description
0	28	DIET
28	52	GRANITE
52	53	SHALE
53	118	GRANITE
118	119	SHALE
119	125	GRANITE

9. TOP OF CASING IS 1 FT. Above Land Surface*
*Top of casing terminated at/or below land surface requires a variance in accordance with 15A NCAC 2C.0118
 10. YIELD (gpm): 30 METHOD OF TEST Air
 11. WATER ZONES (depth): 5.00 gpm 52-53 25.00 gpm 118-119
0.00 gpm 0.00 gpm
 12. CHLORINATION: Type HTH Amount 22

13. CASING:

From	To	Depth	Diameter	Wall Thickness or Weight/Ft.	Material
0	32	Ft.	6 1/8	350	PVC
From	To	Ft.			
From	To	Ft.			

14. GROUT:

From	To	Depth	Material	Method
0	32	Ft.	Cement	Gravity Flow
From	To	Ft.		


15. SCREEN:

From	To	Depth	Diameter	Slot Size	Material
From	To	Ft.	in.	in.	
From	To	Ft.	in.	in.	
From	To	Ft.	in.	in.	

16. SAND/GRAVEL PACK:

From	To	Depth	Size	Material
From	To	Ft.		
From	To	Ft.		

17. REMARKS: _____
 I DO HEREBY CERTIFY THAT THIS WELL WAS CONSTRUCTED IN ACCORDANCE WITH 15A NCAC 2C, WELL CONSTRUCTION STANDARDS, AND THAT A COPY OF THIS RECORD HAS BEEN PROVIDED TO THE WELL OWNER.

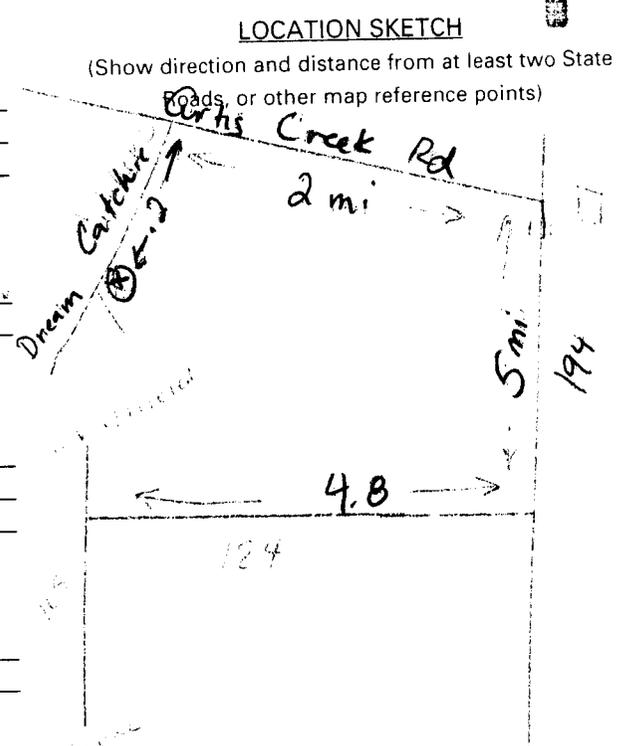

RECD BY CERTIFIED MAIL
 JUN 25 2005
 05

FOR OFFICE USE ONLY
 Quad No: _____

Steve Petry 5-3-05
 SIGNATURE OF PERSON CONSTRUCTING THE WELL DATE
 Submit original to Division of Water Quality, Groundwater Section within 30 days
 GW-1 REV. 12/99