

312153

WELL CONSTRUCTION RECORD

WELL CONTRACTOR: Dewey Wright Well Pump Co., Inc
 WELL CONTRACTOR CERTIFICATION #: 2378
 STATE WELL CONSTRUCTION PERMIT#: Steve Price

040322

1. WELL USE (Check Applicable Box): Residential Municipal Industrial Agricultural Monitoring
 Recovery Heat Pump Water Injection Other If Other, List Use: _____

2. WELL LOCATION: (Show sketch of the location below)
 Nearest Town: INVERSHIELD County: AVERY
DEER CREEK FALLS OFF BEECH MTN PRKWY OFF 194
(Road Name and Numbers, Community, or Subdivision and Lot No.)

3. _____
 4. DATE DRILLED 5/16/2006
 5. TOTAL DEPTH 405
 6. CUTTINGS COLLECTED YES NO
 7. DOES WELL REPLACE EXISTING WELL? YES NO
 8. STATIC WATER LEVEL Below Top of Casing: 100 FT.
(Use "+" if Above Top of Casing)

DRILLING LOG		DEPTH
From	To	Formation/Description
0	38	DIRT
38	120	GRANITE
120	121	QUARTZ
121	230	GRANITE
230	231	QUARTZ
231	390	GRANITE
390	391	QUARTZ
391	405	GRANITE

RECORD BY CENTRAL FILES
JUN-2-05


If additional space is needed use back of form

9. TOP OF CASING IS 1 FT. Above Land Surface*
*Top of casing terminated at/or below land surface requires a variance in accordance with 15A NCAC 2C.0118
 10. YIELD (gpm): 0 METHOD OF TEST Air
 11. WATER ZONES (depth): 1.00 gpm 120-121 1.00 gpm 230-231
4.00 gpm 390-391 0.00 gpm
 12. CHLORINATION: Type HTH Amount 64

13. CASING:

Depth	Diameter	Wall Thickness or Weight/Ft.	Material
From <u>0</u> To <u>44</u> Ft.	<u>8 1/8</u>	<u>350</u>	<u>PVC</u>
From _____ To _____ Ft.	_____	_____	_____
From _____ To _____ Ft.	_____	_____	_____

LOCATION SKETCH
 (Show direction and distance from at least two State Roads, or other map reference points)

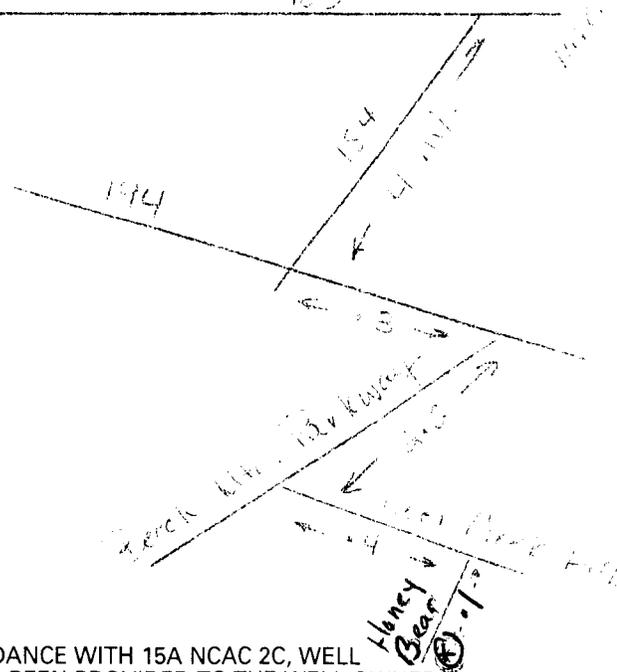

14. GROUT:

Depth	Material	Method
From <u>0</u> To <u>20</u> Ft.	<u>Cement</u>	<u>Gravity Flow</u>
From _____ To _____ Ft.	_____	_____

15. SCREEN:

Depth	Diameter	Slot Size	Material
From _____ To _____ Ft.	_____ in.	_____ in.	_____
From _____ To _____ Ft.	_____ in.	_____ in.	_____
From _____ To _____ Ft.	_____ in.	_____ in.	_____

16. SAND/GRAVEL PACK:

Depth	Size	Material
From _____ To _____ Ft.	_____	_____
From _____ To _____ Ft.	_____	_____

17. REMARKS: _____
 I DO HEREBY CERTIFY THAT THIS WELL WAS CONSTRUCTED IN ACCORDANCE WITH 15A NCAC 2C, WELL CONSTRUCTION STANDARDS, AND THAT A COPY OF THIS RECORD HAS BEEN PROVIDED TO THE WELL OWNER.

Steven Price DATE 5-25-05
 SIGNATURE OF PERSON CONSTRUCTING THE WELL

FOR OFFICE USE ONLY
 Quad No: _____
 Serial No: _____