

AKD 314628

# WELL CONSTRUCTION RECORD

WELL CONTRACTOR: Darvey Wright Well Pump Co. Inc.  
 WELL CONTRACTOR CERTIFICATION #: 2681  
 STATE WELL CONSTRUCTION PERMIT#: Steve Petty

050272

1. WELL USE (Check Applicable Box): Residential  Municipal  Industrial  Agricultural  Monitoring   
 Recovery  Heat Pump Water Injection  Other  If Other, List Use: \_\_\_\_\_

2. WELL LOCATION: (Show sketch of the location below)  
 Nearest Town: BANNER FLK County: WEBB

SEECHMUN RD. OFF BUCKEYE RD. OFF HAY 321 OFF  
(Road Name and Numbers, Community, or Subdivision and Lot No.)

DRILLING LOG		DEPTH
From	To	Formation Description
0	37	DIRT
37	125	GRANITE
125	126	SHALE
126	385	GRANITE
385	388	SHALE
388	405	GRANITE

TOP BY CENTRAL TEST JUL 28 2005

3. DATE DRILLED 6/14/2005  
 4. TOTAL DEPTH 405  
 5. CUTTINGS COLLECTED YES  NO   
 6. DOES WELL REPLACE EXISTING WELL? YES  NO   
 7. STATIC WATER LEVEL Below Top of Casing: 125 FT.  
(Use "+" if Above Top of Casing)

9. TOP OF CASING IS 0 FT. Above Land Surface\*  
\*Top of casing terminated at/or below land surface requires a variance in accordance with 15A NCAC 2C.0118  
 10. YIELD (gpm): 5 METHOD OF TEST 4r  
 11. WATER ZONES (depth): 2.00 gpm 125-126 3.00 gpm 385-388  
0.00 gpm 0.00 gpm  
 12. CHLORINATION: Type HTH Amount 56

If additional space is needed use back of form

13. CASING:

From	To	Depth	Diameter	Wall Thickness or Weight/Ft.	Material
0	32	Ft.	8 1/8	350	PVC
32	405	Ft.			

14. GROUT:

From	To	Depth	Material	Method
0	21	Ft.	Cement	Gravity Flow


15. SCREEN:

From	To	Depth	Diameter	Slot Size	Material
		Ft.	in.	in.	

16. SAND/GRAVEL PACK:

From	To	Depth	Size	Material
		Ft.		

17. REMARKS: \_\_\_\_\_

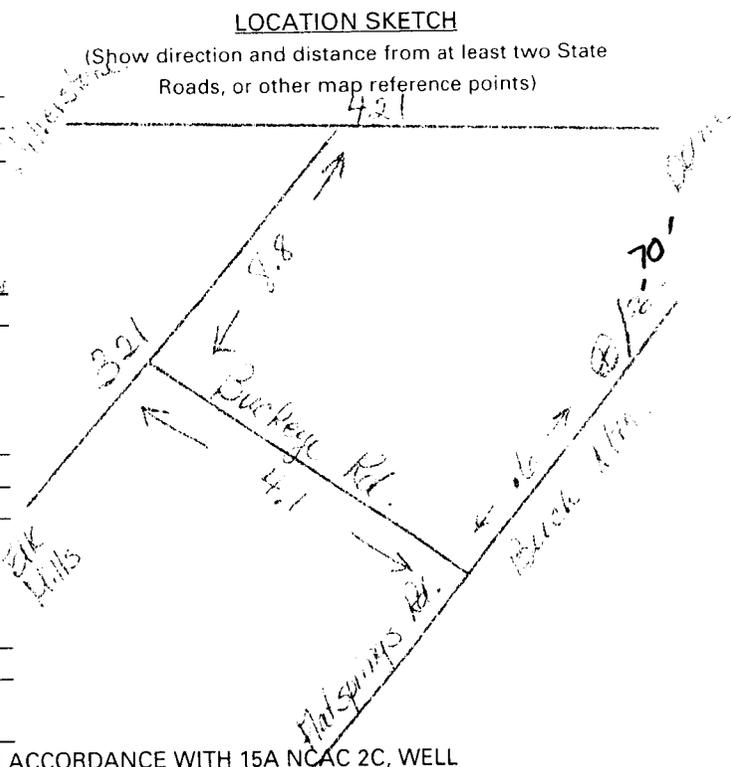

**FOR OFFICE USE ONLY**  
 Quad No: \_\_\_\_\_  
 Serial No: \_\_\_\_\_

Steve Petty  
 SIGNATURE OF PERSON CONSTRUCTING THE WELL  
 DATE 6-29-05  
 Submit original to Division of Water Quality, Groundwater Section within 30 days  
 GW-1 REV. 12/99