

AWD

315350

WELL CONSTRUCTION RECORD

WELL CONTRACTOR: Dewey Wright Well Pump Co. Inc
 WELL CONTRACTOR CERTIFICATION #: 2587
 STATE WELL CONSTRUCTION PERMIT#: Steve Reece

050282

1. WELL USE (Check Applicable Box): Residential Municipal Industrial Agricultural Monitoring
 Recovery Heat Pump Water Injection Other If Other, List Use: _____

2. WELL LOCATION: (Show sketch of the location below)
 Nearest Town: LINVILLE County: AVERY
STOVER RIDGE RD. OFF NEW VALE RD. OFF 194 OFF 1
(Road Name and Numbers, Community, or Subdivision and Lot No.)

3. DATE DRILLED: 6/22/2005
 4. TOTAL DEPTH: 480
 5. CUTTINGS COLLECTED YES NO
 6. DOES WELL REPLACE EXISTING WELL? YES NO
 7. STATIC WATER LEVEL Below Top of Casing: 80 FT.
(Use "+" if Above Top of Casing)


DRILLING LOG		DEPTH
From	To	Formation Description
0	40	DIRT
40	100	GRANITE SHALE
100	104	SHALE
104	300	GRANITE
300	393	GRANITE
393	435	GRANITE
435	438	QUARTZ
438	480	GRANITE

AUG 22 2005

9. TOP OF CASING IS 1 FT. Above Land Surface*
*Top of casing terminated at/or below land surface requires a variance in accordance with 15A NCAC 2C.0118
 10. YIELD (gpm): 7 METHOD OF TEST Air
 11. WATER ZONES (depth): 0.25 gpm 100-104 0.75 gpm 390-393
6.00 gpm 435-438 0.60 gpm
 12. CHLORINATION: Type HTH Amount 78

13. CASING:

From	To	Depth	Diameter	Wall Thickness or Weight/Ft.	Material
0	15	Ft.	6 1/8	350	PVC
15	480	Ft.			

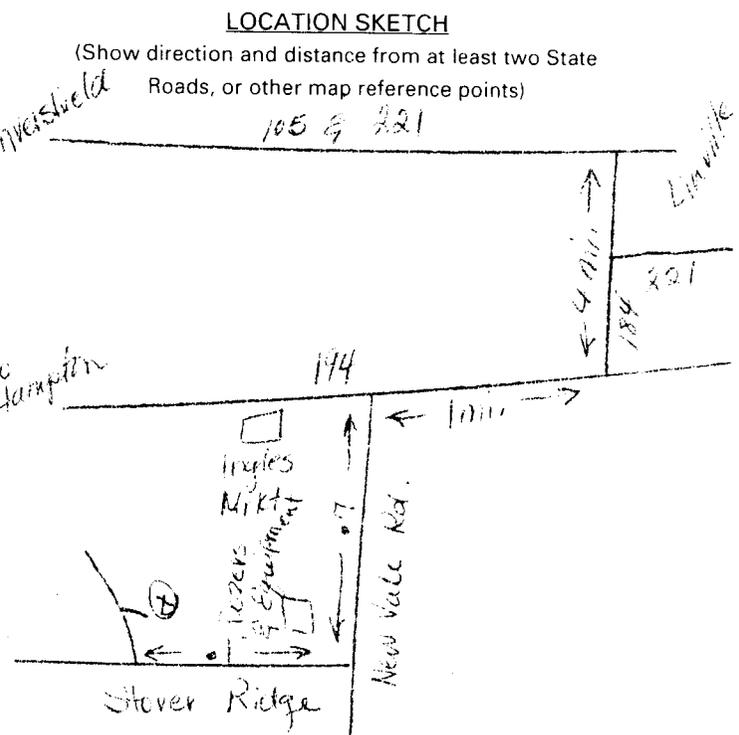

14. GROUT:

From	To	Depth	Material	Method
0	20	Ft.	Cement	Gravity Flow
20	480	Ft.		

15. SCREEN:

From	To	Depth	Diameter	Slot Size	Material
		Ft.	in.	in.	
		Ft.	in.	in.	
		Ft.	in.	in.	

16. SAND/GRAVEL PACK:

From	To	Depth	Size	Material
		Ft.		
		Ft.		

17. REMARKS:
 I DO HEREBY CERTIFY THAT THIS WELL WAS CONSTRUCTED IN ACCORDANCE WITH 15A NCAC 2C, WELL CONSTRUCTION STANDARDS, AND THAT A COPY OF THIS RECORD HAS BEEN PROVIDED TO THE WELL OWNER.

Steve Reece 8-11-05

FOR OFFICE USE ONLY
 Quad No: _____
 Serial No: _____