

ARO

316234

WELL CONSTRUCTION RECORD

WELL CONTRACTOR: Dewey Wright Well Pump Co. Inc.
 WELL CONTRACTOR CERTIFICATION #: 2978
 STATE WELL CONSTRUCTION PERMIT#: Steve Price

040474

1. WELL USE (Check Applicable Box): Residential Municipal Industrial Agricultural Monitoring
 Recovery Heat Pump Water Injection Other If Other, List Use: _____

2. WELL LOCATION: (Show sketch of the location below)
 Nearest Town: BOONE County: AVERY
HUCKLEBERRY LANE OFF WILD APPLE DR. OFF 221 0
(Road Name and Numbers, Community, or Subdivision and Lot No.)

DRILLING LOG		DEPTH
From	To	Formation/Description
0	16	DIRT
16	240	GRANITE
240	241	QUARTZ
241	285	GRANITE
285	286	QUARTZ
286	305	GRANITE
		SEP 16 05

3. _____
 4. DATE DRILLED 8/17/2005
 5. TOTAL DEPTH 305
 6. CUTTINGS COLLECTED YES NO
 7. DOES WELL REPLACE EXISTING WELL? YES NO
 8. STATIC WATER LEVEL Below Top of Casing: 30 FT.
(Use "+" if Above Top of Casing)

9. TOP OF CASING IS 1 FT. Above Land Surface*
*Top of casing terminated at or below land surface requires a variance in accordance with 15A NCAC 2C.0118
 10. YIELD (gpm): 3 METHOD OF TEST Air
 11. WATER ZONES (depth): 1.00 gpm 240-241 2.00 gpm 285-286
0.00 gpm 0.00 gpm
 12. CHLORINATION: Type HTH Amount 48

13. CASING:

From	To	Depth	Diameter	Wall Thickness or Weight/Ft.	Material
0	23	Ft.	8 1/4	168	GALV
23		Ft.			
		Ft.			

14. GROUT:

From	To	Depth	Material	Method
0	20	Ft.	Cement	Gravity Flow
20		Ft.		
		Ft.		

15. SCREEN:


From	To	Depth	Diameter	Slot Size	Material
		Ft.	in.	in.	
		Ft.	in.	in.	
		Ft.	in.	in.	

16. SAND/GRAVEL PACK:

From	To	Depth	Size	Material
		Ft.		
		Ft.		

17. REMARKS: _____

LOCATION SKETCH
 (Show direction and distance from at least two State Roads, or other map reference points)

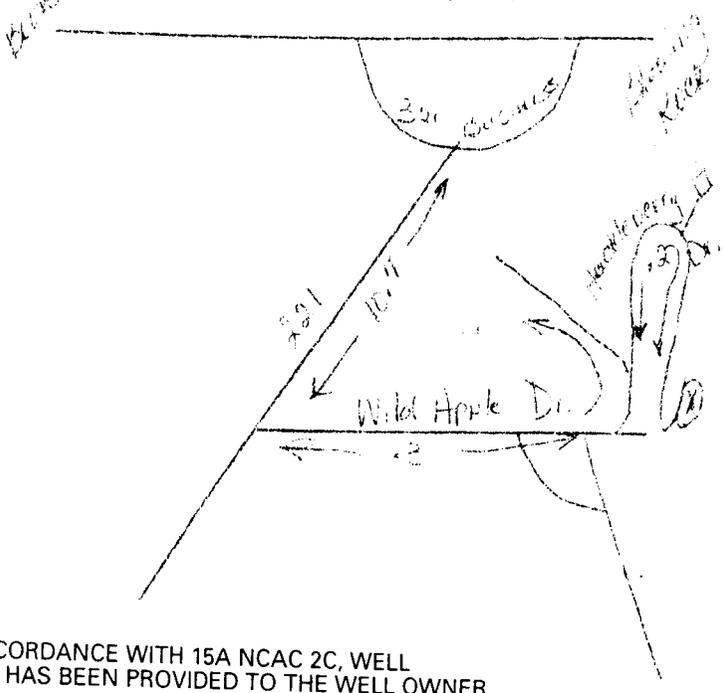

I DO HEREBY CERTIFY THAT THIS WELL WAS CONSTRUCTED IN ACCORDANCE WITH 15A NCAC 2C, WELL CONSTRUCTION STANDARDS, AND THAT A COPY OF THIS RECORD HAS BEEN PROVIDED TO THE WELL OWNER.

Steve Price

9-9-05

SIGNATURE OF PERSON CONSTRUCTING THE WELL
 Submit original to Division of Water Quality, Groundwater Section within 30 days

DATE

FOR OFFICE USE ONLY
 Quad No: _____
 Serial No. _____