

**WELL CONSTRUCTION RECORD**

WELL CONTRACTOR: Davey Wright Well Pump Co., Inc  
 WELL CONTRACTOR CERTIFICATION #: 2687  
 STATE WELL CONSTRUCTION PERMIT#: Steve Reece

050423

1. WELL USE (Check Applicable Box): Residential  Municipal  Industrial  Agricultural  Monitoring   
 Recovery  Heat Pump Water Injection  Other  If Other, List Use: \_\_\_\_\_

2. WELL LOCATION: (Show sketch of the location below)  
 Nearest Town: INVERSHIELD County: AVERY  
LOT # 18 OFF DOUBLE KNOR OFF RIVER RUN OFF PUD  
(Road Name and Numbers, Community, or Subdivision and Lot No.)


3. DATE DRILLED 11/3/05  
 4. TOTAL DEPTH 465  
 5. CUTTINGS COLLECTED YES  NO   
 6. DOES WELL REPLACE EXISTING WELL? YES  NO   
 7. STATIC WATER LEVEL Below Top of Casing: 150 FT.  
(Use "+" if Above Top of Casing)

DRILLING LOG		DEPTH
From	To	Formation Description
0	50	DIRT
50	410	GRANITE
410	412	QUARTZ
412	465	GRANITE
NOV 16 05		
If additional space is needed use back of form		

9. TOP OF CASING IS 1 FT. Above Land Surface\*  
\*Top of casing terminated at/or below land surface requires a variance in accordance with 15A NCAC 2C.0118  
 10. YIELD (gpm): 3.2 METHOD OF TEST Air  
 11. WATER ZONES (depth): 3.00 gpm 410-412 0.00 gpm  
0.00 gpm 0.00 gpm  
 12. CHLORINATION: Type HTH Amount 05

13. CASING:

From	To	Depth	Diameter	Wall Thickness or Weight/Ft.	Material
0	62	Ft.	4 1/2	350	PVC
62	_____	Ft.	_____	_____	_____
_____	_____	Ft.	_____	_____	_____

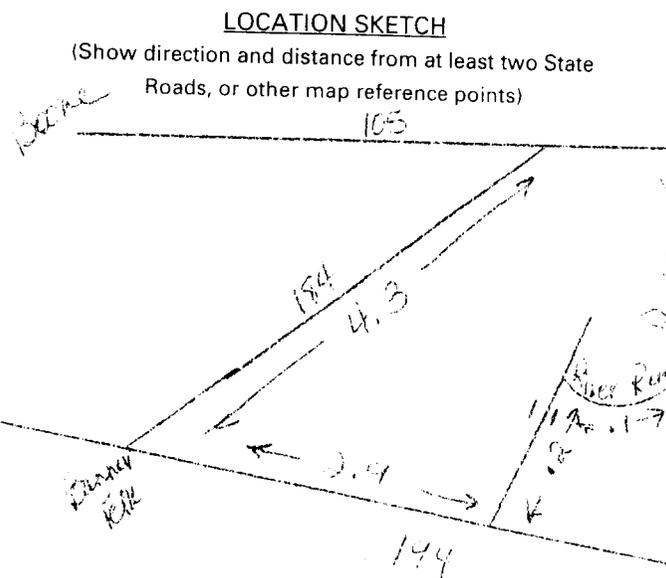

14. GROUT:

From	To	Depth	Material	Method
0	20	Ft.	Cement	Gravity Flow
_____	_____	Ft.	_____	_____

15. SCREEN:

From	To	Depth	Diameter	Slot Size	Material
_____	_____	Ft.	_____ in.	_____ in.	_____
_____	_____	Ft.	_____ in.	_____ in.	_____
_____	_____	Ft.	_____ in.	_____ in.	_____

16. SAND/GRAVEL PACK:

From	To	Depth	Size	Material
_____	_____	Ft.	_____	_____
_____	_____	Ft.	_____	_____

17. REMARKS: \_\_\_\_\_

I DO HEREBY CERTIFY THAT THIS WELL WAS CONSTRUCTED IN ACCORDANCE WITH 15A NCAC 2C, WELL CONSTRUCTION STANDARDS, AND THAT A COPY OF THIS RECORD HAS BEEN PROVIDED TO THE WELL OWNER.

Steve Reece 11-4-05  
 SIGNATURE OF PERSON CONSTRUCTING THE WELL DATE

Submit original to Division of Water Quality, Groundwater Section within 30 days

**FOR OFFICE USE ONLY**  
 Quad No: \_\_\_\_\_  
 Serial No. \_\_\_\_\_