

# WELL CONSTRUCTION RECORD

820928

North Carolina - Department of Environment and Natural Resources - Division of Water Quality - Groundwater Section

WELL CONTRACTOR (INDIVIDUAL) NAME (print) GARY JUSTICE CERTIFICATION # 2150  
 WELL CONTRACTOR COMPANY NAME JUSTICE WELL DRILLING PHONE # (828) 724-4848  
 STATE WELL CONSTRUCTION PERMIT# \_\_\_\_\_ ASSOCIATED WQ PERMIT# \_\_\_\_\_  
 (if applicable) (if applicable)

1. WELL USE (Check Applicable Box): Residential  Municipal/Public  Industrial  Agricultural   
 Monitoring  Recovery  Heat Pump Water Injection  Other  If Other, List Use \_\_\_\_\_

2. WELL LOCATION:  
 Nearest Town: Spring Pine County AVERY  
Brushy Creek Rd  
 (Street Name, Numbers, Community, Subdivision, Lot No., Zip Code)

Topographic/Land setting  
 Ridge  Slope  Valley  Flat  
 (check appropriate box)  
 Latitude/longitude of well location \_\_\_\_\_

3. \_\_\_\_\_  
 (degrees/minutes/seconds)  
 Latitude/longitude source:  GPS  Topographic map  
 (check box)

DEPTH		DRILLING LOG
From	To	Formation Description
0	50	DIRT
50	89	BROWN SAND & ROCK
89	95	SOFT BROWN ROCK
95	168	GRAVEL

Area code- Phone number \_\_\_\_\_  
 4. DATE DRILLED 10-14-05  
 5. TOTAL DEPTH: 168  
 6. DOES WELL REPLACE EXISTING WELL? YES  NO   
 7. STATIC WATER LEVEL Below Top of Casing: 40 FT.  
 (Use "+" if Above Top of Casing)  
 8. TOP OF CASING IS 1 FT. Above Land Surface\*  
 \*Top of casing terminated at/or below land surface requires a variance in accordance with 15A NCAC 2C .0118.  
 9. YIELD (gpm): 75+ METHOD OF TEST AIR  
 10. WATER ZONES (depth): 75 by 140

11. DISINFECTION: Type CHLORINE Amount 802  
 12. CASING:


Depth	Diameter	Wall Thickness	Material
From To Ft.	Ft.	or Weight/Ft.	
From 0 To 102 Ft.	6 1/4	48	PVC
From 102 To 104 Ft.	6 1/4	188	GRAVEL

13. GROUT: Depth \_\_\_\_\_ Diameter \_\_\_\_\_ Material \_\_\_\_\_ Method \_\_\_\_\_

14. SCREEN: Depth \_\_\_\_\_ Diameter \_\_\_\_\_ Slot Size \_\_\_\_\_ Material \_\_\_\_\_

15. SAND/GRAVEL PACK: Depth \_\_\_\_\_ Size \_\_\_\_\_ Material \_\_\_\_\_

16. REMARKS: \_\_\_\_\_

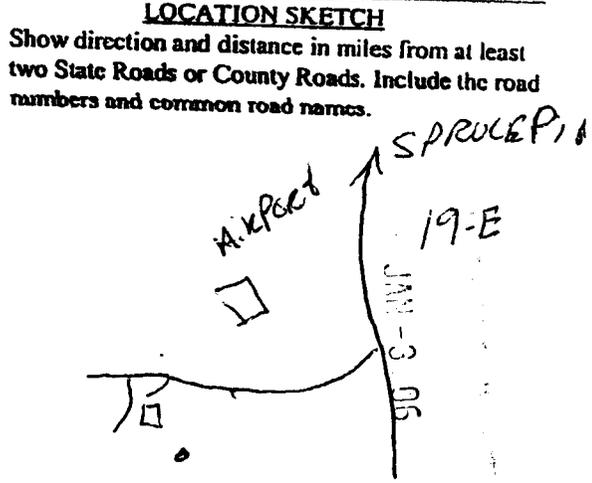

I DO HEREBY CERTIFY THAT THIS WELL WAS CONSTRUCTED IN ACCORDANCE WITH 15A NCAC 2C, WELL CONSTRUCTION STANDARDS, AND THAT A COPY OF THIS RECORD HAS BEEN PROVIDED TO THE WELL OWNER

Gary Justice  
 SIGNATURE OF PERSON CONSTRUCTING THE WELL DATE \_\_\_\_\_