

Eddie

WELL CONSTRUCTION RECORD

387541

North Carolina - Department of Environment and Natural Resources - Division of Water Quality - Groundwater Section

WELL CONTRACTOR (INDIVIDUAL) NAME (print) Gary Justice CERTIFICATION # 2150

WELL CONTRACTOR COMPANY NAME Justice Well Drilling PHONE # 888-724-4548

STATE WELL CONSTRUCTION PERMIT# _____ ASSOCIATED WQ PERMIT# _____
(if applicable) (if applicable)

1. WELL USE (Check Applicable Box): Residential Municipal/Public Industrial Agricultural
Monitoring Recovery Heat Pump Water Injection Other If Other, List Use _____

2. WELL LOCATION:
Nearest Town: Spice Pine County Avery
Old Hanging Rock Rd.
(Street Name, Numbers, Community, Subdivision, Lot No., Zip Code)

Topographic/Land setting
 Ridge Slope Valley Flat
(check appropriate box)

Latitude/longitude of well location
35° 58.354' N 082° 01.421' W
(degrees/minutes/seconds)

Latitude/longitude source: GPS Topographic map
(check box)

DEPTH		DRILLING LOG
From	To	Formation Description
<u>0</u>	<u>45</u>	<u>DIRT</u>
<u>0</u>	<u>505</u>	<u>GRAVITE</u>

Area code- Phone number

4. DATE DRILLED 10-6-06

5. TOTAL DEPTH: 505

6. DOES WELL REPLACE EXISTING WELL? YES NO

7. STATIC WATER LEVEL Below Top of Casing: 40 FT.
(Use "+" if Above Top of Casing)


8. TOP OF CASING IS 1 FT. Above Land Surface*
*Top of casing terminated at/or below land surface requires a variance in accordance with 15A NCAC 2C .0118.

9. YIELD (gpm): 2 METHOD OF TEST AIR

10. WATER ZONES (depth): _____

LOCATION SKETCH

Show direction and distance in miles from at least two State Roads or County Roads. Include the road numbers and common road names.

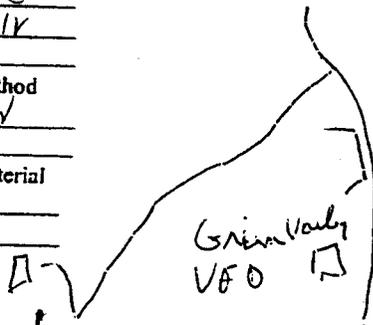

RECEIVED
DIV. OF WATER QUALITY

JAN 26 2007

11. DISINFECTION: Type Chlorine Amount 9 oz

12. CASING:		Depth	Diameter	Wall Thickness	Material
From	To	Ft.	Ft.	or Weight/Ft.	
<u>0</u>	<u>49</u>	<u>6 1/4</u>	<u>40</u>	<u>PVC</u>	
<u>49</u>	<u>51</u>	<u>6 1/4</u>	<u>188</u>	<u>Galv</u>	

13. GROUT:		Depth	Material	Method
From	To	Ft.		
<u>0</u>	<u>20</u>	<u>2 1/2</u>	<u>Pumped</u>	

14. SCREEN:		Depth	Diameter	Slot Size	Material
From	To	Ft.	in.	in.	

15. SAND/GRAVEL PACK:		Depth	Size	Material
From	To	Ft.		

16. REMARKS: _____

I DO HEREBY CERTIFY THAT THIS WELL WAS CONSTRUCTED IN ACCORDANCE WITH 15A NCAC 2C, WELL CONSTRUCTION STANDARDS, AND THAT A COPY OF THIS RECORD HAS BEEN PROVIDED TO THE WELL OWNER

Gary Justice SIGNATURE OF PERSON CONSTRUCTING THE WELL DATE 10-5-06