

234347

WELL CONSTRUCTION RECORD

WELL CONTRACTOR: Dewey Wright Well Pump Co., Inc.
 WELL CONTRACTOR CERTIFICATION #: 2686
 STATE WELL CONSTRUCTION PERMIT#: Leslie Reece

010393

1. WELL USE (Check Applicable Box): Residential Municipal Industrial Agricultural Monitoring
 Recovery Heat Pump Water Injection Other If Other, List Use: _____

2. WELL LOCATION: (Show sketch of the location below)
 Nearest Town: BOONE County: AVERY
FLATSPRINGS CEMETERY RD. OFF FLATSPRINGS RD.
(Road Name and Numbers, Community, or Subdivision and 1 or 2)

3. DRILLING LOG

From	To	DEPTH Formation Description
0	121	DIRT
121	137	GRANITE
137	138	SHALE
138	165	GRANITE
165	166	SHALE
166	185	GRANITE

4. DATE DRILLED 6/14/2001
 5. TOTAL DEPTH 185
 6. CUTTINGS COLLECTED YES NO
 7. DOES WELL REPLACE EXISTING WELL? YES NO
 8. STATIC WATER LEVEL Below Top of Casing: 30 FT.
(Use "+" if Above Top of Casing)

9. TOP OF CASING IS 1 FT. Above Land Surface
*Top of casing terminated at or below land surface requires a variance in accordance with 15A NCAC 2C.0118
 10. YIELD (gpm): 7 METHOD OF TEST Air
 11. WATER ZONES (depth): 3 gpm 137-138 4 gpm 165
0 gpm 0 gpm
 12. CHLORINATION: Type HTH Amount 31

13. CASING:

From	To	Depth	Diameter	Wall Thickness or Weight/Ft.	Material
0	125	Ft.	8 1/8	350	PVC
125	185	Ft.			
185	185	Ft.			

14. GROUT:

From	To	Depth	Material	Method
0	20	Ft.	Cement	Gravity Flow
20	185	Ft.		

15. SCREEN:

From	To	Depth	Diameter	Slot Size	Material
		Ft.	in.	in.	
		Ft.	in.	in.	
		Ft.	in.	in.	

16. SAND/GRAVEL PACK:

From	To	Depth	Size	Material
		Ft.		
		Ft.		


17. REMARKS: _____
 I DO HEREBY CERTIFY THAT THIS WELL WAS CONSTRUCTED IN ACCORDANCE WITH 15A NCAC 2C, WELL CONSTRUCTION STANDARDS, AND THAT A COPY OF THIS RECORD HAS BEEN PROVIDED TO THE WELL OWNER.

DRILLING LOG

From	To	DEPTH Formation Description
0	121	DIRT
121	137	GRANITE
137	138	SHALE
138	165	GRANITE
165	166	SHALE
166	185	GRANITE

RECEIVED

If additional space is needed use back of form

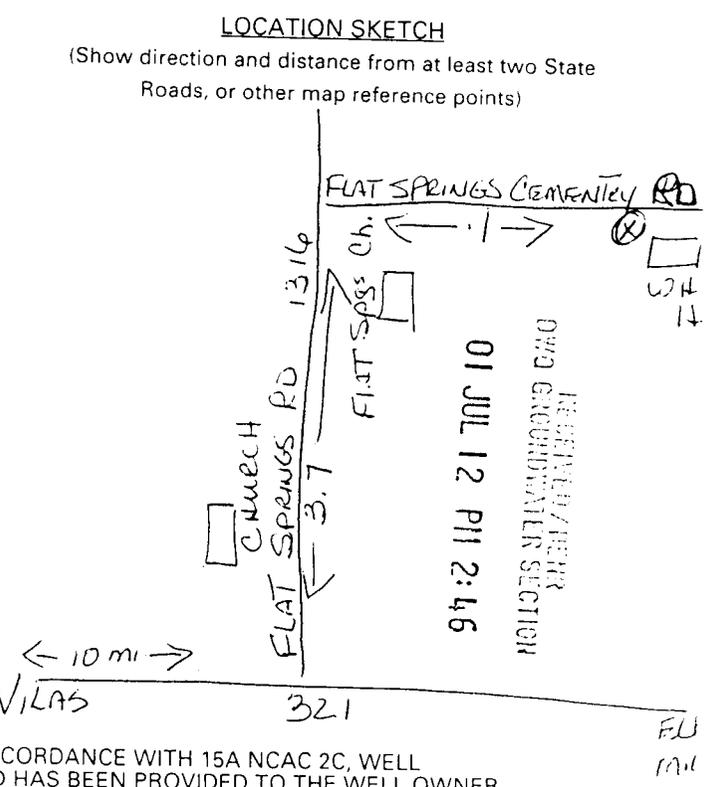

FOR OFFICE USE ONLY
 Quad No: _____
 Serial No: _____

Leslie Wayne Reece 7-6-01
 SIGNATURE OF PERSON CONSTRUCTING THE WELL DATE
 Submit original to Division of Water Quality, Groundwater Section within 30 days
 GW-1 REV 12/99