

239717

WELL CONSTRUCTION RECORD

WELL CONTRACTOR: BRAIDELL Well Drilling
 WELL CONTRACTOR CERTIFICATION #: 2069
 STATE WELL CONSTRUCTION PERMIT#: _____

1. WELL USE (Check Applicable Box): Residential Municipal Industrial Agricultural Monitoring
 Recovery Heat Pump Water Injection Other If Other, List Use: private

2. WELL LOCATION: (Show sketch of the location below)
 Nearest Town: Montezuma County: Avery
Molley BR RD
 (Road Name and Numbers, Community, or Subdivision and Lot No.)

DRILLING LOG		DEPTH
From	To	Formation Description
0	34	red dirt shales
34	38	brown dirt
37	150	granite
150	155	pink slate
155	200	granite

3. DATE DRILLED 10-3-01
 4. TOTAL DEPTH _____
 5. CUTTINGS COLLECTED YES NO
 6. DOES WELL REPLACE EXISTING WELL? YES NO
 7. STATIC WATER LEVEL Below Top of Casing: _____ FT.
 (Use "*" if Above Top of Casing)
 8. TOP OF CASING IS 2 FT. Above Land Surface*

*Top of casing terminated at/or below land surface requires a variance in accordance with 15A NCAC 2C .0118
 9. YIELD (gpm): 20 METHOD OF TEST Air
 10. WATER ZONES (depth): 150-155 200

11. CHLORINATION: Type HTH Amount 302
 12. CASING: _____

If additional space is needed use back of _____


From	Depth	To	Diameter	Wall Thickness or Weight/FT.	Material
-1	41	Fl.	6-3	138	Galv
_____	_____	Fl.	_____	_____	_____
_____	_____	Fl.	_____	_____	_____

From	Depth	To	Material	Method
0	20	Fl.	concrete	pour
_____	_____	Fl.	_____	_____

From	Depth	To	Diameter	Slot Size	Material
_____	_____	Fl.	_____	_____	_____
_____	_____	Fl.	_____	_____	_____
_____	_____	Fl.	_____	_____	_____

From	Depth	To	Size	Material
_____	_____	Fl.	_____	_____
_____	_____	Fl.	_____	_____

13. REMARKS: _____

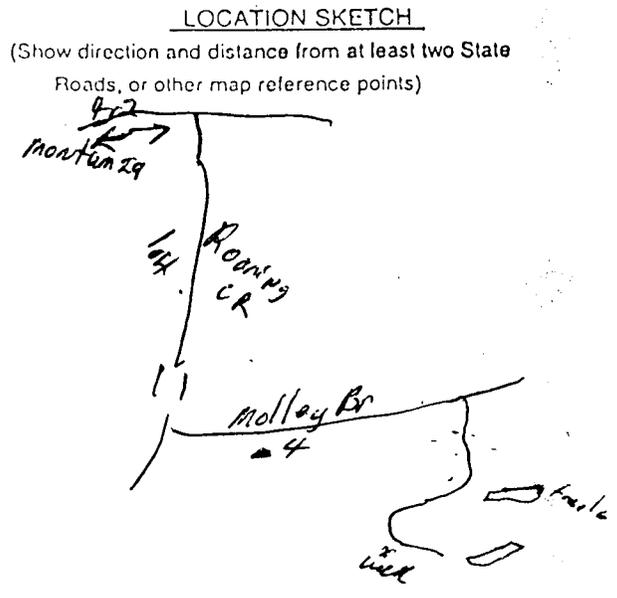

RECEIVED
 DIVISION OF WATER SECTION
 01 OCT 25 PM 1:58

I DO HEREBY CERTIFY THAT THIS WELL WAS CONSTRUCTED IN ACCORDANCE WITH 15A NCAC 2C, WELL CONSTRUCTION STANDARDS, AND THAT A COPY OF THIS RECORD HAS BEEN PROVIDED TO THE WELL OWNER.

FOR OFFICE USE ONLY
 Quad No: _____
 Serial No. _____

SIGNATURE OF PERSON CONSTRUCTING THE WELL: Keith Jones DATE: 10-4-01
 Submit original to Division of Water Quality, Groundwater Section within 30 days

