

239834

WELL CONSTRUCTION RECORD

WELL CONTRACTOR: Dewey Wright Well Pump Co., Inc.
 WELL CONTRACTOR CERTIFICATION #: 2888
 STATE WELL CONSTRUCTION PERMIT#: Leslie Reece

010687

1. WELL USE (Check Applicable Box): Residential Municipal Industrial Agricultural Monitoring
 Recovery Heat Pump Water Injection Other If Other, List Use: _____

2. WELL LOCATION: (Show sketch of the location below)
 Nearest Town: LINVILLE County: AVERY
OFF RICHARD CHILDRESS RD OFF HWY 181 OFF HWY
(Road Name and Numbers, Community, or Subdivision and Lot No.)

DRILLING LOG

DEPTH

From To Formation Description

0	37	DIRT
37	84	GRANITE
84	85	SHALE
85	147	GRANITE
147	148	QUARTZ
148	165	GRANITE

RECEIVED/DEPT
DWD GROUNDWATER SECTION
01 OCT 26 PM 3:25

4. DATE DRILLED 9/7/2001
 5. TOTAL DEPTH 165
 6. CUTTINGS COLLECTED YES NO
 7. DOES WELL REPLACE EXISTING WELL? YES NO
 8. STATIC WATER LEVEL Below Top of Casing: 20 FT.
(Use "+" if Above Top of Casing)

9. TOP OF CASING IS 1 FT. Above Land Surface*
*Top of casing terminated at/or below land surface requires a variance in accordance with 15A NCAC 2C.0118

10. YIELD (gpm): 20 METHOD OF TEST Air
 11. WATER ZONES (depth): 5 gpm 84-85 15 gpm 147-148
0 gpm 0 gpm

12. CHLORINATION: Type HTH Amount 30


If additional space is needed use back of form

13. CASING:

Depth	Diameter	Wall Thickness or Weight/Ft.	Material
From <u>0</u> To <u>2</u> Ft.	<u>6 1/8</u>	<u>350</u>	<u>PVC</u>
From _____ To _____ Ft.	_____	_____	_____
From _____ To _____ Ft.	_____	_____	_____

LOCATION SKETCH

(Show direction and distance from at least two State Roads, or other map reference points)

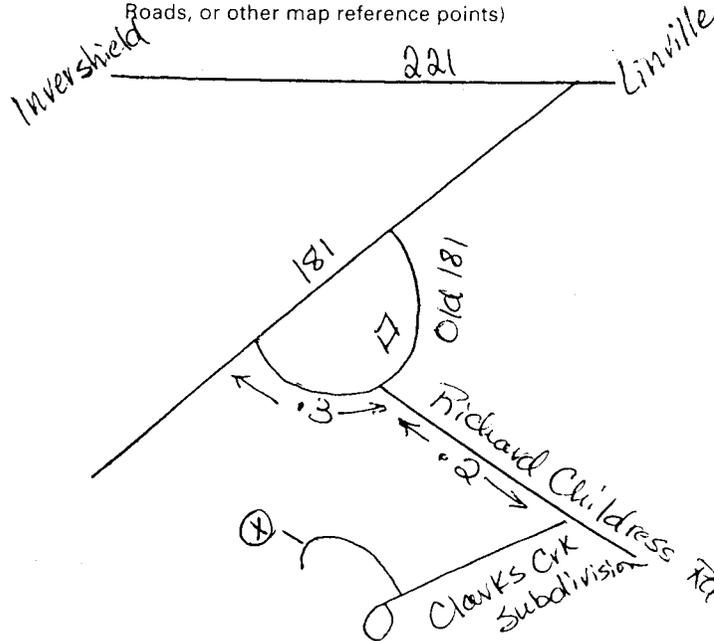

14. GROUT:

Depth	Material	Method
From <u>0</u> To <u>20</u> Ft.	<u>Cement</u>	<u>Gravity Flow</u>
From _____ To _____ Ft.	_____	_____

15. SCREEN:

Depth	Diameter	Slot Size	Material
From _____ To _____ Ft.	_____ in.	_____ in.	_____
From _____ To _____ Ft.	_____ in.	_____ in.	_____
From _____ To _____ Ft.	_____ in.	_____ in.	_____

16. SAND/GRAVEL PACK:

Depth	Size	Material
From _____ To _____ Ft.	_____	_____
From _____ To _____ Ft.	_____	_____

17. REMARKS: _____

I DO HEREBY CERTIFY THAT THIS WELL WAS CONSTRUCTED IN ACCORDANCE WITH 15A NCAC 2C, WELL CONSTRUCTION STANDARDS, AND THAT A COPY OF THIS RECORD HAS BEEN PROVIDED TO THE WELL OWNER.

FOR OFFICE USE ONLY

Quad No: _____

Serial No. _____

Groundwater Section
Asheville Regional Office

Submit original to Division of Water Quality, Groundwater Section within 30 days

Leslie Wayne Reece

SIGNATURE OF PERSON CONSTRUCTING THE WELL

10-18-01

DATE