

239836

WELL CONSTRUCTION RECORD

WELL CONTRACTOR: Dewey Wright Well Pump Co., Inc.
 WELL CONTRACTOR CERTIFICATION #: 2686
 STATE WELL CONSTRUCTION PERMIT#: Leslie Reece

010655

1. WELL USE (Check Applicable Box): Residential Municipal Industrial Agricultural Monitoring
 Recovery Heat Pump Water Injection Other If Other, List Use: _____

2. WELL LOCATION: (Show sketch of the location below)
 Nearest Town: BANNER ELK County: AWERY
SHANTY SPRINGS OFF ADAMS APPLE DR. OFF HWY 10
(Road Name and Numbers, Community, or Subdivision and Lot No.)

3. _____
 4. DATE DRILLED 9/12/2001
 5. TOTAL DEPTH 145
 6. CUTTINGS COLLECTED YES NO
 7. DOES WELL REPLACE EXISTING WELL? YES NO
 8. STATIC WATER LEVEL Below Top of Casing: 30 FT.
(Use "+" if Above Top of Casing)

DRILLING LOG		DEPTH
From	To	Formation Description
0	37	DIRT
37	81	GRANITE
81	82	SHALE
82	124	GRANITE
124	125	SHALE
125	145	GRANITE


RECEIVED / DENR
 DWQ GROUNDWATER SECTION
 01 OCT 26 PM 3:25

9. TOP OF CASING IS 1 FT. Above Land Surface*
*Top of casing terminated at/or below land surface requires a variance in accordance with 15A NCAC 2C.0118
 10. YIELD (gpm): 10 METHOD OF TEST Air
 11. WATER ZONES (depth): 3 gpm 81-82 7 gpm 124-125
0 gpm 0 gpm
 12. CHLORINATION: Type HTH Amount 23

13. CASING:

Depth	Diameter	Wall Thickness or Weight/Ft.	Material
From <u>0</u> To <u>46</u> Ft.	<u>6 1/8</u>	<u>350</u>	<u>PVC</u>
From _____ To _____ Ft.	_____	_____	_____
From _____ To _____ Ft.	_____	_____	_____

LOCATION SKETCH
 (Show direction and distance from at least two State Roads, or other map reference points)

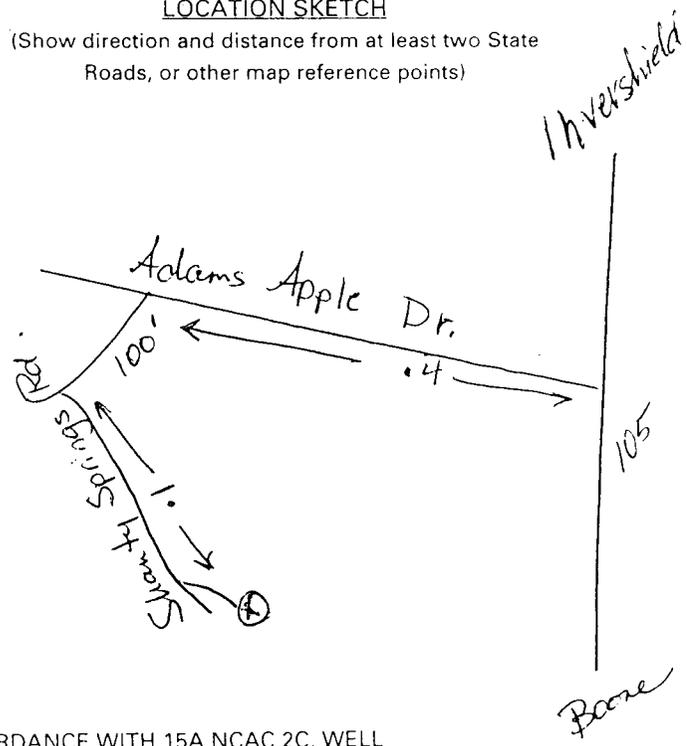

14. GROUT:

Depth	Material	Method
From <u>0</u> To <u>20</u> Ft.	<u>Cement</u>	<u>Gravity Flow</u>
From _____ To _____ Ft.	_____	_____

15. SCREEN:

Depth	Diameter	Slot Size	Material
From _____ To _____ Ft.	_____ in.	_____ in.	_____
From _____ To _____ Ft.	_____ in.	_____ in.	_____
From _____ To _____ Ft.	_____ in.	_____ in.	_____

16. SAND/GRAVEL PACK:

Depth	Size	Material
From _____ To _____ Ft.	_____	_____
From _____ To _____ Ft.	_____	_____

17. REMARKS:
 I DO HEREBY CERTIFY THAT THIS WELL WAS CONSTRUCTED IN ACCORDANCE WITH 15A NCAC 2C, WELL CONSTRUCTION STANDARDS, AND THAT A COPY OF THIS RECORD HAS BEEN PROVIDED TO THE WELL OWNER.
Leslie Wayne Reece 10-18-01
 SIGNATURE OF PERSON CONSTRUCTING THE WELL DATE

FOR OFFICE USE ONLY

Groundwater Section
 Asheville Regional Office

Serial No. _____

Submit original to Division of Water Quality, Groundwater Section within 30 days