

241535

Dewey Wright Well Pump Co

WELL CONSTRUCTION RECORD

WELL CONTRACTOR: Dewey Wright Well Pump Co
 WELL CONTRACTOR CERTIFICATION #: 2687 2687
 STATE WELL CONSTRUCTION PERMIT#: Steve Reece

010478-1

1. WELL USE (Check Applicable Box): Residential Municipal Industrial Agricultural Monitoring
 Recovery Heat Pump Water Injection Other If Other, List Use: _____

2. WELL LOCATION: (Show sketch of the location below)
 Nearest Town: LINVILLE County: AVERY
CREST TRAIL RD OFF OFF RIDGE DR OFF HWY 105
(Road Name and Numbers, Community, or Subdivision and Lot No.)

3.	DRILLING LOG		DEPTH
	From	To	Formation Description
	0	30	DIRT
	30	900	GRANITE
4.	DATE DRILLED <u>7/11/2001</u>		
5.	TOTAL DEPTH <u>900</u>		
6.	CUTTINGS COLLECTED YES <input type="checkbox"/> NO <input checked="" type="checkbox"/>		
7.	DOES WELL REPLACE EXISTING WELL? YES <input type="checkbox"/> NO <input checked="" type="checkbox"/>		
8.	STATIC WATER LEVEL Below Top of Casing: <u>40</u> FT. <small>(Use "+" if Above Top of Casing)</small>		
9.	TOP OF CASING IS <u>1</u> FT. Above Land Surface* <small>*Top of casing terminated at/or below land surface requires a variance in accordance with 15A NCAC 2C.0118</small>		
10.	YIELD (gpm): <u>0</u> METHOD OF TEST <u>Air</u>		
11.	WATER ZONES (depth): <u>0</u> gpm DRY HOLE <u>0</u> gpm <u>0</u> gpm <u>0</u> gpm		
12.	CHLORINATION: Type <u>HTH</u> Amount _____ <small>If additional space is needed use back of form</small>		

13. CASING:

From	To	Depth	Diameter	Wall Thickness or Weight/Ft.	Material
0	35	Ft.	8 1/4	198	GALV.
35	_____	Ft.	_____	_____	_____
_____	_____	Ft.	_____	_____	_____

14. GROUT:

From	To	Depth	Material	Method
0	20	Ft.	Cement	Gravity Flow
20	_____	Ft.	_____	_____


15. SCREEN:

From	To	Depth	Diameter	Slot Size	Material
_____	_____	Ft.	_____ in.	_____ in.	_____
_____	_____	Ft.	_____ in.	_____ in.	_____
_____	_____	Ft.	_____ in.	_____ in.	_____

16. SAND/GRAVEL PACK:

From	To	Depth	Size	Material
_____	_____	Ft.	_____	_____
_____	_____	Ft.	_____	_____

17. REMARKS:
 I DO HEREBY CERTIFY THAT THIS WELL WAS CONSTRUCTED IN ACCORDANCE WITH 15A NCAC 2C, WELL CONSTRUCTION STANDARDS, AND THAT A COPY OF THIS RECORD HAS BEEN PROVIDED TO THE WELL OWNER.

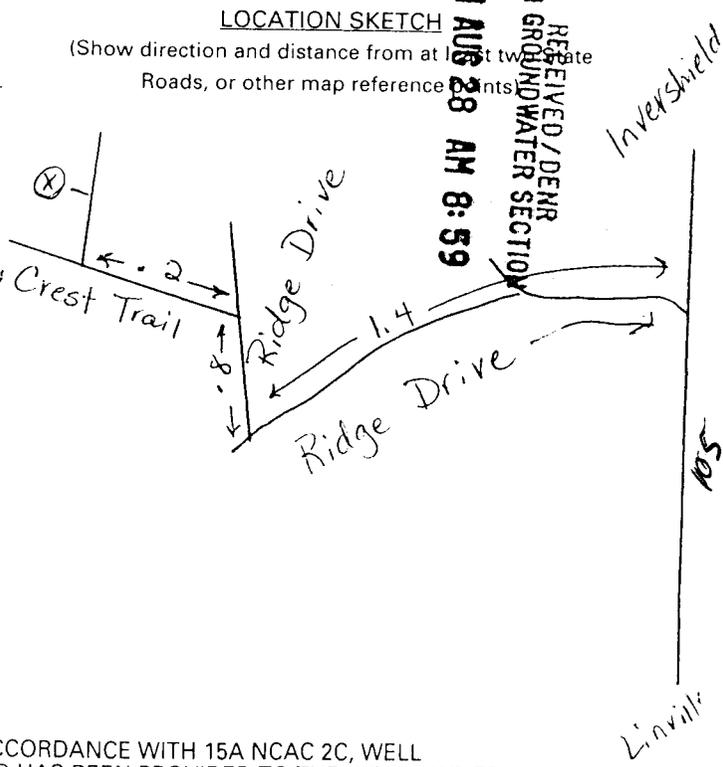

FOR OFFICE USE ONLY
 Quad No: _____
 Serial No. _____

Steve Reece 8-9-01
 SIGNATURE OF PERSON CONSTRUCTING THE WELL DATE
 Submit original to Division of Water Quality, Groundwater Section within 30 days