

241554

WELL CONSTRUCTION RECORD

010410-2

WELL CONTRACTOR: Dewey Wright Well Pump Co., Inc
 WELL CONTRACTOR CERTIFICATION #: 2888
 STATE WELL CONSTRUCTION PERMIT#: Leslie Reece

1. WELL USE (Check Applicable Box): Residential Municipal Industrial Agricultural Monitoring
 Recovery Heat Pump Water Injection Other If Other, List Use: _____

2. WELL LOCATION: (Show sketch of the location below)
 Nearest Town: BANNER ELK County: AVERY
PRIVATE DR. OFF RUSSELL NORRIS RD. OFF BUCK EYE
(Road Name and Numbers, Community, or Subdivision)

3. DATE DRILLED 7/12/2001
 4. TOTAL DEPTH 505
 6. CUTTINGS COLLECTED YES NO
 7. DOES WELL REPLACE EXISTING WELL? YES NO
 8. STATIC WATER LEVEL Below Top of Casing: _____ FT.
(Use "+" if Above Top of Casing)

DRILLING LOG		DEPTH
From	To	Formation Description
0	60	DIRT
60	505	GRANITE
RECEIVED/DENR DWO GROUNDWATER SECTION 01 AUG 28 AM 8:59		

9. TOP OF CASING IS 1 FT. Above Land Surface*
*Top of casing terminated at or below land surface requires a variance in accordance with 15A NCAC 2C.0118
 10. YIELD (gpm): 0 METHOD OF TEST Air
 11. WATER ZONES (depth): 0 gpm DRY HOLE 0 gpm
0 gpm 0 gpm
 12. CHLORINATION: Type HTH Amount _____

13. CASING:

From	To	Depth	Diameter	Wall Thickness or Weight/Ft.	Material
0	68ft.		8 1/8	350	PVC
From	To	Ft.			
From	To	Ft.			

14. GROUT:

From	To	Depth	Material	Method
0	20 Ft.		Cement	Gravity Flow
From	To	Ft.		


15. SCREEN:

From	To	Depth	Diameter	Slot Size	Material
From	To	Ft.	in.	in.	
From	To	Ft.	in.	in.	
From	To	Ft.	in.	in.	

16. SAND/GRAVEL PACK:

From	To	Depth	Size	Material
From	To	Ft.		
From	To	Ft.		

17. REMARKS:
 I DO HEREBY CERTIFY THAT THIS WELL WAS CONSTRUCTED IN ACCORDANCE WITH 15A NCAC 2C, WELL CONSTRUCTION STANDARDS AND THAT A COPY OF THIS RECORD HAS BEEN PROVIDED TO THE WELL OWNER.
 ASHVILLE REGIONAL OFFICE

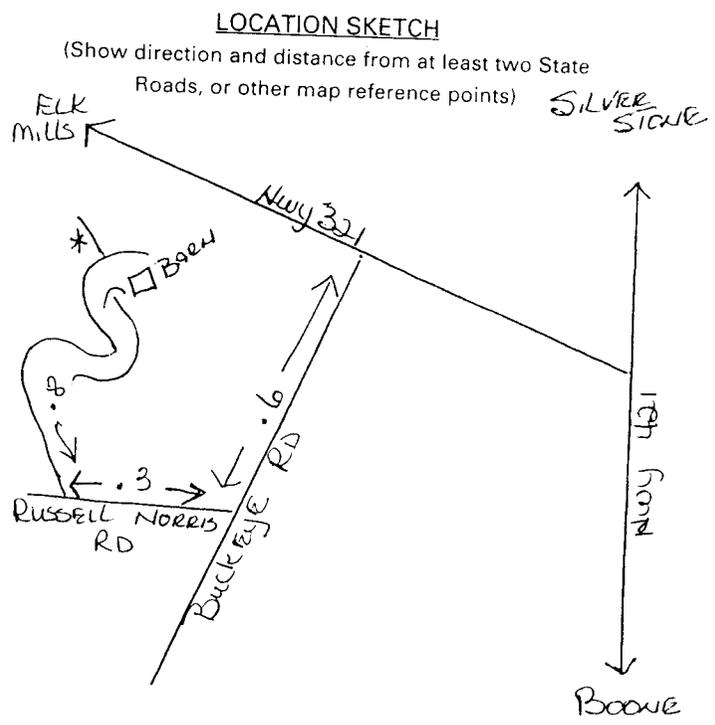

FOR OFFICE USE ONLY
 Quad No: _____
 Serial No. _____

Steve Reece 8-21-01
 SIGNATURE OF PERSON CONSTRUCTING THE WELL DATE
 Submit original to Division of Water Quality, Groundwater Section within 30 days