

241579

WELL CONSTRUCTION RECORD

010478-2

WELL CONTRACTOR: Dewey Wright Well Pump Co., Inc.
 WELL CONTRACTOR CERTIFICATION #: 2887
 STATE WELL CONSTRUCTION PERMIT#: Steve Reece

1. WELL USE (Check Applicable Box): Residential Municipal Industrial Agricultural Monitoring
 Recovery Heat Pump Water Injection Other If Other, List Use: _____

2. WELL LOCATION: (Show sketch of the location below)
 Nearest Town: LINVILLE County: AVERY
CREST TRAIL OFF RIDGE DR. OFF HWY 105
(Road Name and Numbers, Community, or Subdivision and Lot No.)


3. DATE DRILLED 7/12/2001
 4. TOTAL DEPTH 800
 5. CUTTINGS COLLECTED YES NO
 6. DOES WELL REPLACE EXISTING WELL? YES NO
 7. STATIC WATER LEVEL Below Top of Casing: 40 FT.
(Use "+" if Above Top of Casing)
 8. TOP OF CASING IS 1 FT. Above Land Surface*
*Top of casing terminated at/or below land surface requires a variance in accordance with 15A NCAC 2C.0118
 9. YIELD (gpm): 4 METHOD OF TEST Air
 10. WATER ZONES (depth): 4 gpm 60-64 0 gpm
0 gpm 0 gpm
 11. CHLORINATION: Type HTH Amount 114

DRILLING LOG		DEPTH
From	To	Formation Description
0	38	DIRT
38	60	GRANITE/SHALE
60	64	SHALE
64	70	GRANITE/SHALE
70	800	GRANITE

If additional space is needed use back of form

RECEIVED/DENR SECTION
 DIVISION OF GROUNDWATER SECTION
 01 AUG 28 AM 8:59

13. CASING:
 Depth From 0 To 46 Ft. Diameter 6 1/4 Wall Thickness or Weight/Ft. 188 Material GALV.
 From _____ To _____ Ft. _____
 From _____ To _____ Ft. _____

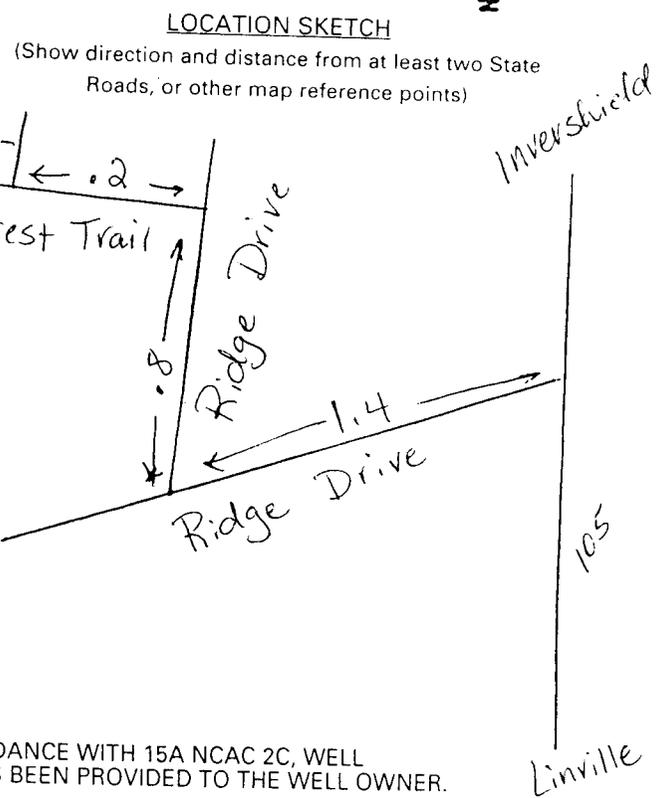

14. GROUT:
 Depth From 0 To 20 Ft. Material Cement Method Gravity Flow
 From _____ To _____ Ft. _____

15. SCREEN:
 Depth From _____ To _____ Ft. Diameter _____ Slot Size _____ Material _____
 From _____ To _____ Ft. _____
 From _____ To _____ Ft. _____

16. SAND/GRAVEL PACK:
 Depth From _____ To _____ Ft. Size _____ Material _____
 From _____ To _____ Ft. _____

RECEIVED

GROUNDWATER SECTION
 ASHLEIGH REGIONAL OFFICE

17. REMARKS:
 I DO HEREBY CERTIFY THAT THIS WELL WAS CONSTRUCTED IN ACCORDANCE WITH 15A NCAC 2C, WELL CONSTRUCTION STANDARDS, AND THAT A COPY OF THIS RECORD HAS BEEN PROVIDED TO THE WELL OWNER.
Steve Reece 8-9-01

FOR OFFICE USE ONLY
 Quad No: _____
 Serial No. _____

SIGNATURE OF PERSON CONSTRUCTING THE WELL DATE
 Submit original to Division of Water Quality, Groundwater Section within 30 days