

242351

WELL CONSTRUCTION RECORD

WELL CONTRACTOR: Dewey Wright Well Pump Co., Inc.
 WELL CONTRACTOR CERTIFICATION #: 2881
 STATE WELL CONSTRUCTION PERMIT #: Steve Petty

010811

1. WELL USE (Check Applicable Box): Residential Municipal Industrial Agricultural Monitoring
 Recovery Heat Pump Water Injection Other If Other, List Use: _____

2. WELL LOCATION: (Show sketch of the location below)
 Nearest Town: BANNER ELK County: AVERY
PRIVATE DR. OFF PUCKETT RD. OFF HWY 194 OFF H
(Road Name and Numbers, Community, or Subdivision and Lot No.)

3. ()
 /
 -

4. DATE DRILLED 10/25/2001

5. TOTAL DEPTH 305

6. CUTTINGS COLLECTED YES NO

7. DOES WELL REPLACE EXISTING WELL? YES NO

8. STATIC WATER LEVEL Below Top of Casing: 3 FT.
(Use "+" if Above Top of Casing)

DRILLING LOG		DEPTH
From	To	Formation Description
0	105	DIRT/SAND
105	280	GRANITE
280	282	QUARTZ
282	295	GRANITE
295	297	QUARTZ
297	305	GRANITE

RECEIVED / DENR
DWA GROUNDWATER SECTION
01 NOV 19 PM 4:57

9. TOP OF CASING IS 1 FT. Above Land Surface*
*Top of casing terminated at/or below land surface requires a variance in accordance with 15A NCAC 2C.0118


10. YIELD (gpm): 15 METHOD OF TEST Air

11. WATER ZONES (depth): 1 gpm 280-282 14 gpm 295-297
0 gpm 0 gpm

12. CHLORINATION: Type HTH Amount 64

13. CASING:

Depth	Diameter	Wall Thickness or Weight/Ft.	Material
From <u>0</u> To <u>110</u> Ft.	<u>6 1/8</u>	<u>.350</u>	<u>PVC</u>
From _____ To _____ Ft.	_____	_____	_____
From _____ To _____ Ft.	_____	_____	_____

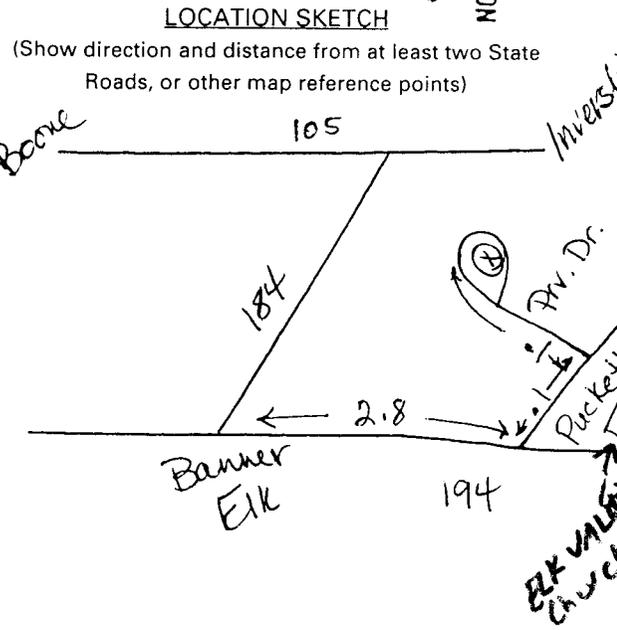

14. GROUT:

Depth	Material	Method
From <u>0</u> To <u>20</u> Ft.	<u>Cement</u>	<u>Gravity Flow</u>
From _____ To _____ Ft.	_____	_____


15. SCREEN:

Depth	Diameter	Slot Size	Material
From _____ To _____ Ft.	_____ in.	_____ in.	_____
From _____ To _____ Ft.	_____ in.	_____ in.	_____

16. SAND/GRAVEL PACK:

Depth	Size	Material
From _____ To _____ Ft.	_____	_____
From _____ To _____ Ft.	_____	_____

17. REMARKS:
 I DO HEREBY CERTIFY THAT THIS WELL WAS CONSTRUCTED IN ACCORDANCE WITH 15A NCAC 2C, WELL CONSTRUCTION STANDARDS, AND THAT A COPY OF THIS RECORD HAS BEEN PROVIDED TO THE WELL OWNER.

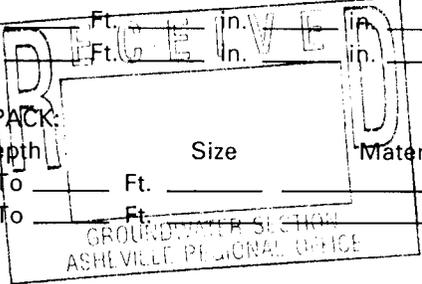

Steve Petty
 SIGNATURE OF PERSON CONSTRUCTING THE WELL

11-12-01
 DATE

FOR OFFICE USE ONLY

Quad No: _____

Serial No. _____