

243803

WELL CONSTRUCTION RECORD

WELL CONTRACTOR: Bramwell Well Drilling
 WELL CONTRACTOR CERTIFICATION #: 2133
 STATE WELL CONSTRUCTION PERMIT#: _____

1. WELL USE (Check Applicable Box): Residential Municipal Industrial Agricultural Monitoring
 Recovery Heat Pump Water Injection Other If Other, List Use: private

2. WELL LOCATION: (Show sketch of the location below)
 Nearest Town: Montezuma County: Avery
Roaring CR RD 2.0 on RT
 (Road Name and Numbers, Community or Subdivision and Lot No.)

DRILLING LOG		DEPTH
From	To	Formation Description
0	82	gravel boulders
82	90	granite
90	93	shale rock
93	100	granite

3. City or town _____ State _____ Zip Code _____
 4. DATE DRILLED 9-18-01
 5. TOTAL DEPTH 100
 6. CUTTINGS COLLECTED YES NO
 7. DOES WELL REPLACE EXISTING WELL? YES NO
 8. STATIC WATER LEVEL Below Top of Casing: 1 FT.
 (Use "+" if Above Top of Casing)
 9. TOP OF CASING IS 1 FT. Above Land Surface*
 *Top of casing terminated at or below land surface requires a variance in accordance with 15A NCAC 2C.0118
 10. YIELD (gpm): 20 METHOD OF TEST Air
 11. WATER ZONES (depth): 90-93 20 gal

12. CHLORINATION: Type HTH Amount 30L
 13. CASING:

From	Depth	To	Diameter	Wall Thickness or Weight/Ft.	Material
<u>1</u>		<u>21</u>	<u>4-3/4</u>	<u>128</u>	<u>Galv.</u>
_____		_____	_____	_____	_____
_____		_____	_____	_____	_____


14. GROUT:
 From 0 To 20 Ft. Material concrete Method poured
 From _____ To _____ Ft. _____

15. SCREEN:
 From _____ To _____ Ft. _____ in. _____ in. _____
 From _____ To _____ Ft. _____ in. _____ in. _____
 From _____ To _____ Ft. _____ in. _____ in. _____

16. SAND/GRAVEL PACK:
 From _____ To _____ Ft. _____ Size _____ Material _____
 From _____ To _____ Ft. _____

17. REMARKS: _____

LOCATION SKETCH
 (Show direction and distance from at least two roads, or other map reference points)

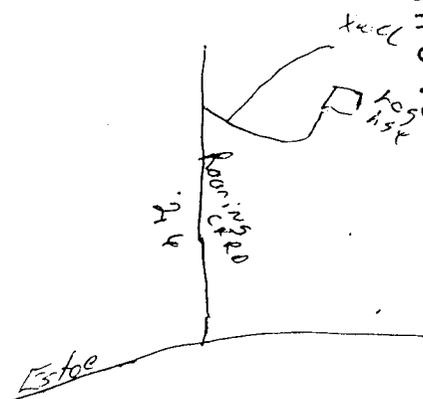

RECEIVED / DENIED
 DIVISION OF GROUNDWATER SECTION
 01 DEC 10 PM 3:15

I DO HEREBY CERTIFY THAT THIS WELL WAS CONSTRUCTED IN ACCORDANCE WITH 15A NCAC 2C, WELL CONSTRUCTION STANDARDS, AND THAT A COPY OF THIS RECORD HAS BEEN PROVIDED TO THE WELL OWNER.

FOR OFFICE USE ONLY

Quad No: _____

Serial No. _____

SIGNATURE OF PERSON CONSTRUCTING THE WELL: [Signature]

DATE: 9-18-01

Submit original to Division of Water Quality, Groundwater Section within 30 days

GW-1 REV. 12/99

RECEIVED
 GROUNDWATER SECTION
 RALEIGH REGIONAL OFFICE