

246630

WELL CONSTRUCTION RECORD

WELL CONTRACTOR: Dewey Wright Well Pump Co., Inc.
 WELL CONTRACTOR CERTIFICATION #: 2081
 STATE WELL CONSTRUCTION PERMIT#: Steve Petty

010018

1. WELL USE (Check Applicable Box): Residential Municipal Industrial Agricultural Monitoring
 Recovery Heat Pump Water Injection Other If Other, List Use: _____

2. WELL LOCATION: (Show sketch of the location below)
 Nearest Town: NEWLAND County: AVERY
OVERLOOK RD OFF COW CAMP RD. OFF OLD TOE RIV
(Road Name and Numbers, Community, or Subdivision and Lot No.)

3. DRILLING LOG

From	To	DEPTH Formation Description
0	65	DIRT
65	180	GRANITE
180	182	QUARTZ
182	306	GRANITE
306	397	QUARTZ
397	405	GRANITE

4. DATE DRILLED 12/5/2001
 5. TOTAL DEPTH 405
 6. CUTTINGS COLLECTED YES NO
 7. DOES WELL REPLACE EXISTING WELL? YES NO
 8. STATIC WATER LEVEL Below Top of Casing: 60 FT.
(Use "+" if Above Top of Casing)

9. TOP OF CASING IS 1 FT. Above Land Surface*
*Top of casing terminated at/or below land surface requires a variance in accordance with 15A NCAC 2C.0118
 10. YIELD (gpm): 3 METHOD OF TEST Air
 11. WATER ZONES (depth): 1 gpm 180-182 2 gpm 306-397
0 gpm 0 gpm
 12. CHLORINATION: Type HTH Amount 70

13. CASING:

From	To	Depth	Diameter	Wall Thickness or Weight/Ft.	Material
0	70	Ft.	6 1/4	188	GALV
70		Ft.			
		Ft.			

14. GROUT:

From	To	Depth	Material	Method
0	20	Ft.	Cement	Gravity Flow
20		Ft.		

15. SCREEN:

From	To	Depth	Diameter	Slot Size	Material
		Ft.	in.	in.	
		Ft.	in.	in.	
		Ft.	in.	in.	

16. SAND/GRAVEL PACK:

From	To	Depth	Size	Material
		Ft.		
		Ft.		


17. REMARKS:
 I DO HEREBY CERTIFY THAT THIS WELL WAS CONSTRUCTED IN ACCORDANCE WITH 15A NCAC 2C, WELL CONSTRUCTION STANDARDS, AND THAT A COPY OF THIS RECORD HAS BEEN PROVIDED TO THE WELL OWNER.

DRILLING LOG

From	To	DEPTH Formation Description
0	65	DIRT
65	180	GRANITE
180	182	QUARTZ
182	306	GRANITE
306	397	QUARTZ
397	405	GRANITE

02 FEB - 4 AM 11:00
 RECEIVED / NEAR
 DIVISION OF WATER QUALITY SECTION

If additional space is needed use back of form

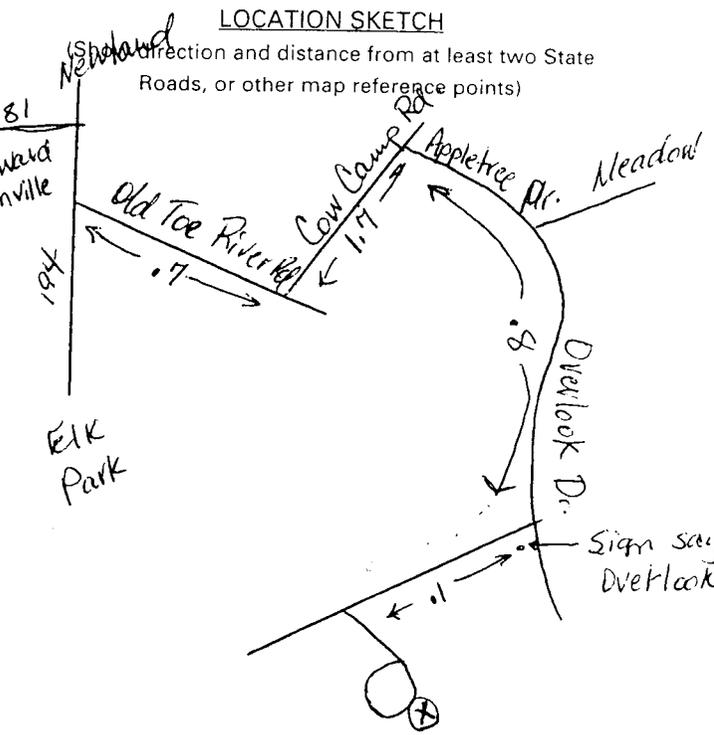

FOR OFFICE USE ONLY
 Quad No: _____
 Serial No: _____

Steve Petty
 SIGNATURE OF PERSON CONSTRUCTING THE WELL
 DATE 1-22-02

Submit original to Division of Water Quality, Groundwater Section within 30 days
 GW-1 REV. 12/99