

246631

WELL CONSTRUCTION RECORD

WELL CONTRACTOR: Dewey Wright Well Pump Co., Inc.
 WELL CONTRACTOR CERTIFICATION #: 2687
 STATE WELL CONSTRUCTION PERMIT#: Steve Petty

010892

1. WELL USE (Check Applicable Box): Residential Municipal Industrial Agricultural Monitoring
 Recovery Heat Pump Water Injection Other If Other, List Use: _____

2. WELL LOCATION: (Show sketch of the location below)
 Nearest Town: LINVILLE County: AVERY
OLD MOTEZUMA RD. OFF HWY 181 OFF HWY 105
(Road Name and Numbers, Community, or Subdivision and Lot No.)

3. DRILLING LOG

From	To	DEPTH	Formation Description
0	20		DIRT
20	35		GRANITE
35	37		QUARTZ
37	70		GRANITE
70	73		SHALE
73	85		GRANITE

4. DATE DRILLED 12/13/2001
 5. TOTAL DEPTH 85
 6. CUTTINGS COLLECTED YES NO
 7. DOES WELL REPLACE EXISTING WELL? YES NO
 8. STATIC WATER LEVEL Below Top of Casing: 10 FT.
(Use "+" if Above Top of Casing)

9. TOP OF CASING IS 1 FT. Above Land Surface*
*Top of casing terminated at/ or below land surface requires a variance in accordance with 15A NCAC 2C.0118
 10. YIELD (gpm): 100 METHOD OF TEST Air
 11. WATER ZONES (depth): 5 gpm 35-37 85 gpm 70-73
0 gpm 0 gpm
 12. CHLORINATION: Type HTH Amount 15

13. CASING:

From	To	Depth	Diameter	Wall Thickness or Weight/Ft.	Material
0	24	Ft.	6 1/8	350	PVC
From	To	Ft.			
From	To	Ft.			

14. GROUT:

From	To	Depth	Material	Method
0	20	Ft.	Cement	Gravity Flow
From	To	Ft.		

15. SCREEN:

From	To	Depth	Diameter	Slot Size	Material
From	To	Ft.	in.	in.	
From	To	Ft.	in.	in.	
From	To	Ft.	in.	in.	

16. SAND/GRAVEL PACK:

From	To	Depth	Size	Material
From	To	Ft.		
From	To	Ft.		


17. REMARKS:
 I DO HEREBY CERTIFY THAT THIS WELL WAS CONSTRUCTED IN ACCORDANCE WITH 15A NCAC 2C, WELL CONSTRUCTION STANDARDS, AND THAT A COPY OF THIS RECORD HAS BEEN PROVIDED TO THE WELL OWNER.

DRILLING LOG

From	To	DEPTH	Formation Description
0	20		DIRT
20	35		GRANITE
35	37		QUARTZ
37	70		GRANITE
70	73		SHALE
73	85		GRANITE

02 FEB - L AM 11:00
 RECEIVED / CENTER
 DIVISION OF WATER QUALITY SECTION

If additional space is needed use back of form

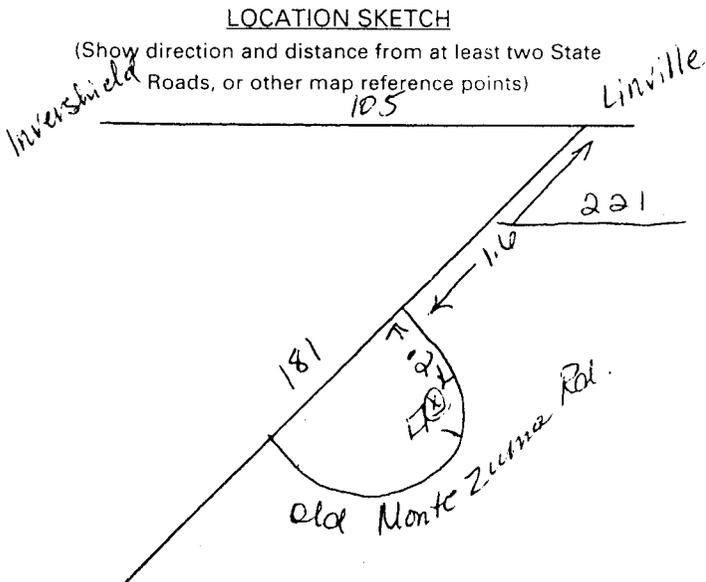

RECEIVED

FOR OFFICE USE ONLY

GROUNDWATER SECTION
 ASHVILLE REGIONAL OFFICE

SIGNATURE OF PERSON CONSTRUCTING THE WELL: Steve Petty DATE: 1-22-02