

248928

WELL CONSTRUCTION RECORD

WELL CONTRACTOR: Bohannon Well Drilling  
WELL CONTRACTOR CERTIFICATION #: 2669  
STATE WELL CONSTRUCTION PERMIT#: \_\_\_\_\_

- 1. WELL USE (Check Applicable Box): Residential  Municipal  Industrial  Agricultural  Monitoring   
Recovery  Heat Pump Water Injection  Other  If Other, List Use: private

2. WELL LOCATION: (Show sketch of the location below)  
Nearest Town: Nepherd County: Avery  
High School Rd.  
(Road Name and Numbers, Community, or Subdivision and Lot No.)

- 3. DATE DRILLED 12-17-01
- 4. TOTAL DEPTH 180
- 5. CUTTINGS COLLECTED YES  NO
- 6. DOES WELL REPLACE EXISTING WELL? YES  NO
- 7. STATIC WATER LEVEL Below Top of Casing: 40 FT.  
(Use "\*" if Above Top of Casing)
- 8. TOP OF CASING IS 1 FT. Above Land Surface\*  
\*Top of casing terminated at/or below land surface requires a variance in accordance with 15A NCAC 2C .0118
- 9. YIELD (gpm): 20 METHOD OF TEST \_\_\_\_\_
- 10. WATER ZONES (depth): 5 gal 88 ft  
150 15 gal
- 11. CHLORINATION: Type HTH Amount 30¢
- 12. CASING:

DEPTH LOG		DEPTH
From	To	Formation Description
0	30	reddint's below
30	86	granite
86	90	crack's, white quartz
90	150	granite
150	155	limestone
155	180	granite

DEPT - 8 MID - 16

From	To	Depth	Diameter	Wall Thickness or Weight/Ft.	Material
1	39	ft.	6 3/4	SPRAL	PUC
From	To	Depth	Diameter	Wall Thickness or Weight/Ft.	Material
From	To	Depth	Diameter	Wall Thickness or Weight/Ft.	Material

14. GROUT:

From	To	Depth	Material	Method
0	20	ft.	concrete	poured
From	To	Depth <th>Material</th> <th>Method</th>	Material	Method

15. SCREEN:


From	To	Depth	Diameter	Slot Size	Material
From	To	Depth	Diameter	Slot Size	Material
From	To	Depth	Diameter	Slot Size	Material

16. SAND/GRAVEL PACK:

From	To	Depth	Size	Material
From	To	Depth	Size	Material
From	To	Depth	Size	Material

17. REMARKS:

LOCATION SKETCH  
(Show direction and distance from at least two State Roads, or other map reference points)

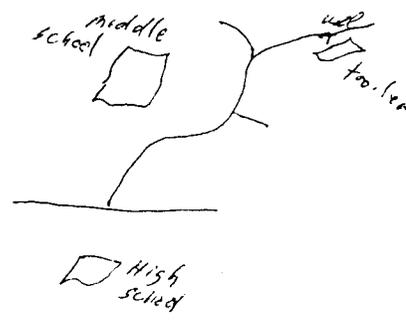

I DO HEREBY CERTIFY THAT THIS WELL WAS CONSTRUCTED IN ACCORDANCE WITH 15A NCAC 2C, WELL CONSTRUCTION STANDARDS, AND THAT A COPY OF THIS RECORD HAS BEEN PROVIDED TO THE WELL OWNER.

FOR OFFICE USE ONLY  
Quad No: \_\_\_\_\_  
Serial No. \_\_\_\_\_

Signature of Person Constructing the Well: North Jordan  
DATE: 12-17-01  
Submit original to Division of Water Quality, Groundwater Section within 30 days

