

WSPA  
 305981

# WELL CONSTRUCTION RECORD

040554

WELL CONTRACTOR: Dewey Wright Well Pump Co., Inc.  
 WELL CONTRACTOR CERTIFICATION #: 2686  
 STATE WELL CONSTRUCTION PERMIT#: Leslie Reece

1. WELL USE (Check Applicable Box): Residential  Municipal  Industrial  Agricultural  Monitoring   
 Recovery  Heat Pump Water Injection  Other  If Other, List Use: \_\_\_\_\_

2. WELL LOCATION: (Show sketch of the location below)  
 Nearest Town: BLOWING ROCK County: WATAUGA  
SKI CREST PARK OFF OLD 321 OFF 321  
(Road Name and Numbers, Community, or Subdivision and Lot No.)

JAN 29 2005

**DRILLING LOG**

From	To	Formation Description
0	77	DIRT
77	103	GRANITE
103	104	QUARTZ
104	308	GRANITE
308	309	SHALE
309	365	GRANITE

3. \_\_\_\_\_  
 4. DATE DRILLED 11/12/2004  
 5. TOTAL DEPTH 365  
 6. CUTTINGS COLLECTED YES  NO   
 7. DOES WELL REPLACE EXISTING WELL? YES  NO   
 8. STATIC WATER LEVEL Below Top of Casing: 60 FT.  
(Use "+" if Above Top of Casing)

9. TOP OF CASING IS 1 FT. Above Land Surface\*  
\*Top of casing terminated at/or below land surface requires a variance in accordance with 15A NCAC 2C.0118  
 10. YIELD (gpm): 10 METHOD OF TEST Air  
 11. WATER ZONES (depth): 2.00 gpm 103-104 8.00 gpm 308-309  
0.00 gpm 0.00 gpm  
 12. CHLORINATION: Type HTH Amount 64

If additional space is needed use back of form

13. CASING:  

From	Depth	To	Diameter	Wall Thickness or Weight/Ft.	Material
0		63 Ft.	6 1/8	.350	PVC
From		To			
From		To			

14. GROUT:  

From	Depth	To	Material	Method
0		20 Ft.	Cement	Gravity Flow
From		To		

15. SCREEN:  

From	Depth	To	Diameter	Slot Size	Material
From		To			
From		To			
From		To			


16. SAND/GRAVEL PACK:  

From	Depth	To	Size	Material
From		To		
From		To		

17. REMARKS:  
 I DO HEREBY CERTIFY THAT THIS WELL WAS CONSTRUCTED IN ACCORDANCE WITH 15A NCAC 2C, WELL CONSTRUCTION STANDARDS, AND THAT A COPY OF THIS RECORD HAS BEEN PROVIDED TO THE WELL OWNER.

**LOCATION SKETCH**

(Show direction and distance from at least two State Roads, or other map reference points)

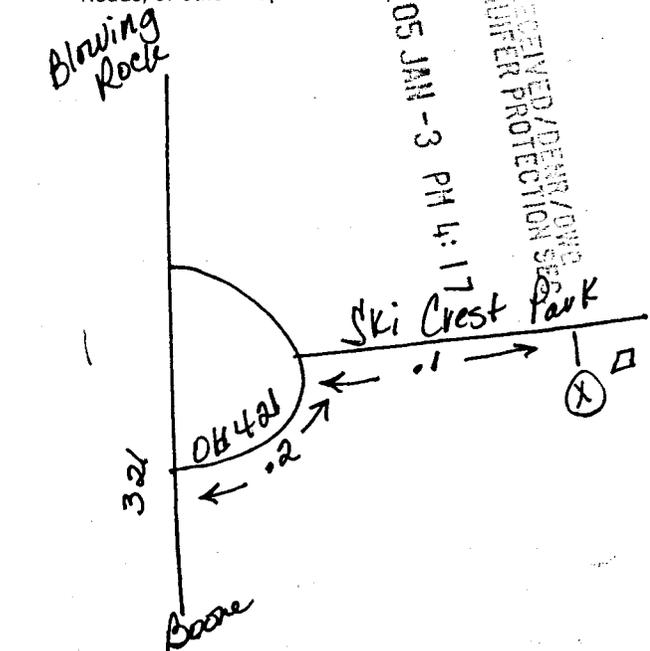

Wayne Reece

12-10-04

**FOR OFFICE USE ONLY**

Quad No: \_\_\_\_\_

Serial No. \_\_\_\_\_

SIGNATURE OF PERSON CONSTRUCTING THE WELL DATE  
 Submit original to Division of Water Quality, Groundwater Section within 30 days GW-1 REV. 12/99