

WISKW
 305982

WELL CONSTRUCTION RECORD

040595

WELL CONTRACTOR: Dewey Wright Well Pump Co., Inc.
 WELL CONTRACTOR CERTIFICATION #: 2888
 STATE WELL CONSTRUCTION PERMIT#: Leslie Reece

1. WELL USE (Check Applicable Box): Residential Municipal Industrial Agricultural Monitoring
 Recovery Heat Pump Water Injection Other If Other, List Use: _____

JAN 31 2005

2. WELL LOCATION: (Show sketch of the location below)
 Nearest Town: BOONE County: WATAUGA
CAMP JOY RD. OFF ODES WILSON RD. OFF SILVERST
(Road Name and Numbers, Community, or Subdivision and Lot No.)

Winston-Salem
 Regional Office

3. DRILLING LOG

From	To	Formation Description
0	40	DIRT
40	96	GRANITE
96	97	QUARTZ
97	405	GRANITE

4. DATE DRILLED 11/16/2004
 5. TOTAL DEPTH 405
 6. CUTTINGS COLLECTED YES NO
 7. DOES WELL REPLACE EXISTING WELL? YES NO
 8. STATIC WATER LEVEL Below Top of Casing: 20 FT.
(Use "+" if Above Top of Casing)

9. TOP OF CASING IS 1 FT. Above Land Surface*
*Top of casing terminated at/or below land surface requires a variance in accordance with 15A NCAC 2C.0118
 10. YIELD (gpm): 0.5 METHOD OF TEST Air
 11. WATER ZONES (depth): 0.50 gpm 96-97 0.00 gpm
0.00 gpm 0.00 gpm
 12. CHLORINATION: Type HTH Amount 76

13. CASING:

From	Depth	To	Diameter	Wall Thickness or Weight/Ft.	Material
0		43 Ft.	6 1/8	.350	PVC
From		To			
From		To			

14. GROUT:

From	Depth	To	Material	Method
0		20 Ft.	Cement	Gravity Flow
From		To		


15. SCREEN:

From	Depth	To	Diameter	Slot Size	Material
From		To			
From		To			
From		To			

16. SAND/GRAVEL PACK:

From	Depth	To	Size	Material
From		To		
From		To		

17. REMARKS: _____
 I DO HEREBY CERTIFY THAT THIS WELL WAS CONSTRUCTED IN ACCORDANCE WITH 15A NCAC 2C, WELL CONSTRUCTION STANDARDS, AND THAT A COPY OF THIS RECORD HAS BEEN PROVIDED TO THE WELL OWNER.

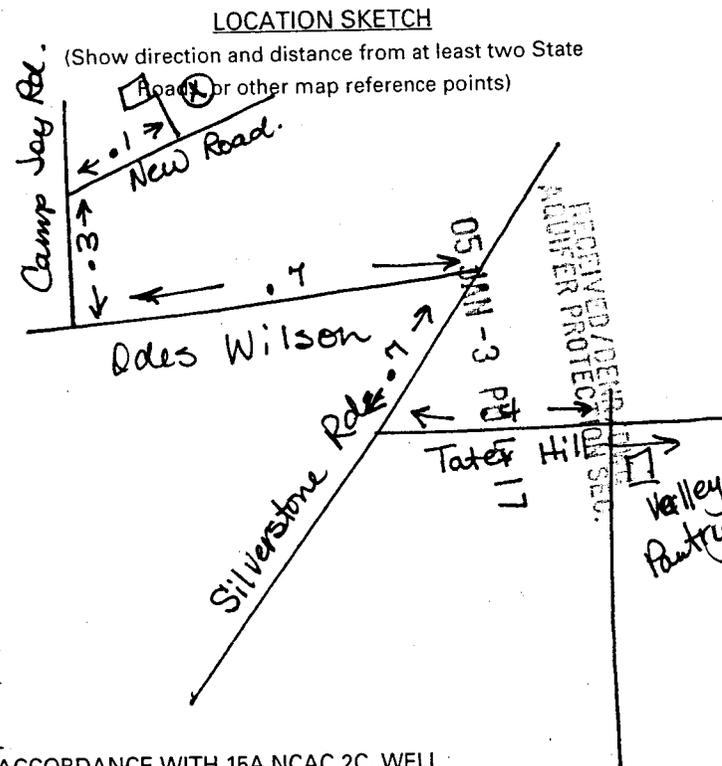

FOR OFFICE USE ONLY

Quad No: _____

Serial No: _____

Wayne Reece 12-10-04
 SIGNATURE OF PERSON CONSTRUCTING THE WELL DATE
 Submit original to Division of Water Quality, Groundwater Section within 30 days
 GW-1 REV. 12/99