

WSR

305998

WELL CONSTRUCTION RECORD

WELL CONTRACTOR: Dewey Wright Well Pump Co., Inc.
 WELL CONTRACTOR CERTIFICATION #: 2881
 STATE WELL CONSTRUCTION PERMIT#: Steve Petty

040387

1. WELL USE (Check Applicable Box): Residential Municipal Industrial Agricultural Monitoring
 Recovery Heat Pump Water Injection Other If Other, List Use: _____

2. WELL LOCATION: (Show sketch of the location below)
 Nearest Town: BOONE County: WATAUGA
RAVEN ROCK MEADOWS DR OFF BOBY GREENE RD
(Road Name and Numbers, Community, or Subdivision and Lot No.)

3. DATE DRILLED 11/2/2004
 4. TOTAL DEPTH 205
 5. CUTTINGS COLLECTED YES NO
 6. DOES WELL REPLACE EXISTING WELL? YES NO
 7. STATIC WATER LEVEL Below Top of Casing: 20 FT.
(Use "+" if Above Top of Casing)

DRILLING LOG		DEPTH
From	To	Formation Description
0	35	DIRT
35	130	GRANITE
130	132	SHALE
132	195	GRANITE
195	197	SHALE
197	205	GRANITE

9. TOP OF CASING IS 1 FT. Above Land Surface*
*Top of casing terminated at/or below land surface requires a variance in accordance with 15A NCAC 2C.0118
 10. YIELD (gpm): 8 METHOD OF TEST Air
 11. WATER ZONES (depth): 1.00 gpm 130-132 5.00 gpm 175-177
0.00 gpm 0.00 gpm

12. CHLORINATION: Type HTH Amount 39

13. CASING:

From	Depth	To	Diameter	Wall Thickness or Weight/Ft.	Material
0		40 Ft.	6 1/8	350	PVC
From		To	Ft.		
From		To	Ft.		

14. GROUT:

From	Depth	To	Material	Method
0		40 Ft.	Cement	PUMPED
From		To	Ft.	


15. SCREEN:

From	Depth	To	Diameter	Slot Size	Material
From		To	Ft.	in.	in.
From		To	Ft.	in.	in.
From		To	Ft.	in.	in.

16. SAND/GRAVEL PACK:

From	Depth	To	Size	Material
From		To	Ft.	
From		To	Ft.	

17. REMARKS: _____

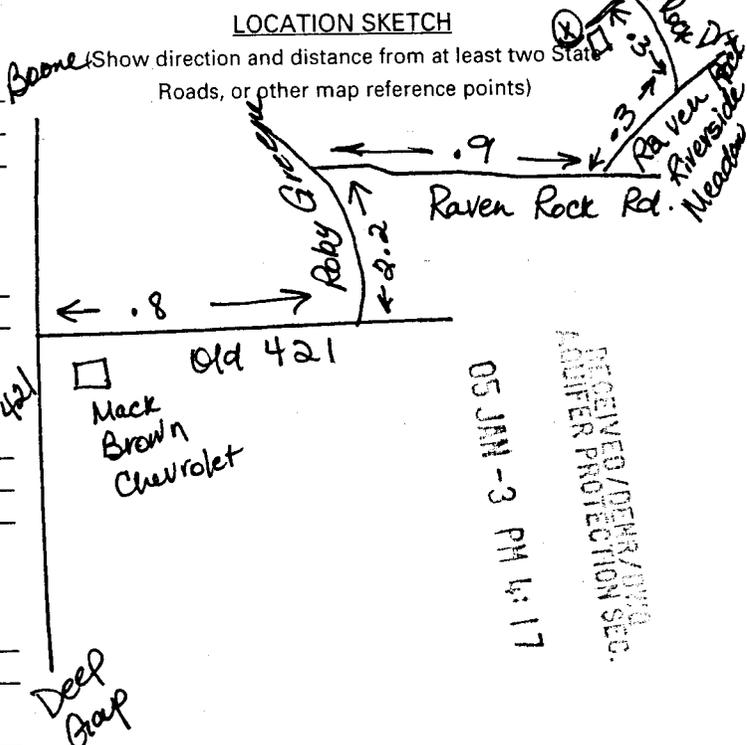

FOR OFFICE USE ONLY
 Quad No: _____
 Serial No: _____

SIGNATURE OF PERSON CONSTRUCTING THE WELL: Steve Petty DATE: 12-10-04
 Submit original to Division of Water Quality, Groundwater Section within 30 days
 GW-1 REV. 12/99