

WSPRO

306003

**WELL CONSTRUCTION RECORD**

040299

WELL CONTRACTOR: Dewey Wright Well Pump Co. Inc.  
 WELL CONTRACTOR CERTIFICATION #: 2878  
 STATE WELL CONSTRUCTION PERMIT#: Steve Price

1. WELL USE (Check Applicable Box): Residential  Municipal  Industrial  Agricultural  Monitoring   
 Recovery  Heat Pump Water Injection  Other  If Other, List Use: \_\_\_\_\_

2. WELL LOCATION: (Show sketch of the location below)  
 Nearest Town: DEEP GAP County: WATAUGA  
NARROW RD MTN VIEW CHURCH RD. OFF STONEY FO  
(Road Name and Numbers, Community, or Subdivision and Lot No.)

3. DATE DRILLED 11/11/2004  
 4. TOTAL DEPTH 305  
 5. CUTTINGS COLLECTED YES  NO   
 6. DOES WELL REPLACE EXISTING WELL? YES  NO   
 7. STATIC WATER LEVEL Below Top of Casing: 80 FT.  
(Use "+" if Above Top of Casing)  
 8. TOP OF CASING IS 1 FT. Above Land Surface\*  
\*Top of casing terminated at/or below land surface requires a variance in accordance with 15A NCAC 2C.0118

DRILLING LOG		DEPTH
From	To	Formation Description
0	70	DIRT
70	170	GRANITE
170	171	SHALE
171	278	GRANITE
278	279	QUARTZ
279	288	GRANITE
288	289	QUARTZ
289	305	GRANITE

9. YIELD (gpm): 6 METHOD OF TEST Air  
 10. WATER ZONES (depth): 1.00 gpm 170-171 1.00 gpm 278-279  
4.00 gpm 288-289 0.00 gpm  
 11. CHLORINATION: Type HTH Amount 48

12. CASING:  
 From 0 Depth 75 Ft. Diameter 6 1/8 Wall Thickness or Weight/Ft. .350 Material PVC  
 From \_\_\_\_\_ To \_\_\_\_\_ Ft. \_\_\_\_\_ \_\_\_\_\_  
 From \_\_\_\_\_ To \_\_\_\_\_ Ft. \_\_\_\_\_ \_\_\_\_\_


LOCATION SKETCH  
 (Show direction and distance from at least two State Roads, or other map reference points)

13. GROUT:  
 From 0 Depth 20 Ft. Material Cement Method Gravity Flow  
 From \_\_\_\_\_ To \_\_\_\_\_ Ft. \_\_\_\_\_ \_\_\_\_\_

14. SCREEN:  
 From \_\_\_\_\_ To \_\_\_\_\_ Ft. \_\_\_\_\_ in. \_\_\_\_\_ in. \_\_\_\_\_  
 From \_\_\_\_\_ To \_\_\_\_\_ Ft. \_\_\_\_\_ in. \_\_\_\_\_ in. \_\_\_\_\_  
 From \_\_\_\_\_ To \_\_\_\_\_ Ft. \_\_\_\_\_ in. \_\_\_\_\_ in. \_\_\_\_\_

15. SAND/GRAVEL PACK:  
 From \_\_\_\_\_ To \_\_\_\_\_ Ft. \_\_\_\_\_ Size \_\_\_\_\_ Material \_\_\_\_\_  
 From \_\_\_\_\_ To \_\_\_\_\_ Ft. \_\_\_\_\_ \_\_\_\_\_ \_\_\_\_\_

16. REMARKS: \_\_\_\_\_  
 I DO HEREBY CERTIFY THAT THIS WELL WAS CONSTRUCTED IN ACCORDANCE WITH 15A NCAC 2C, WELL CONSTRUCTION STANDARDS, AND THAT A COPY OF THIS RECORD HAS BEEN PROVIDED TO THE WELL OWNER.

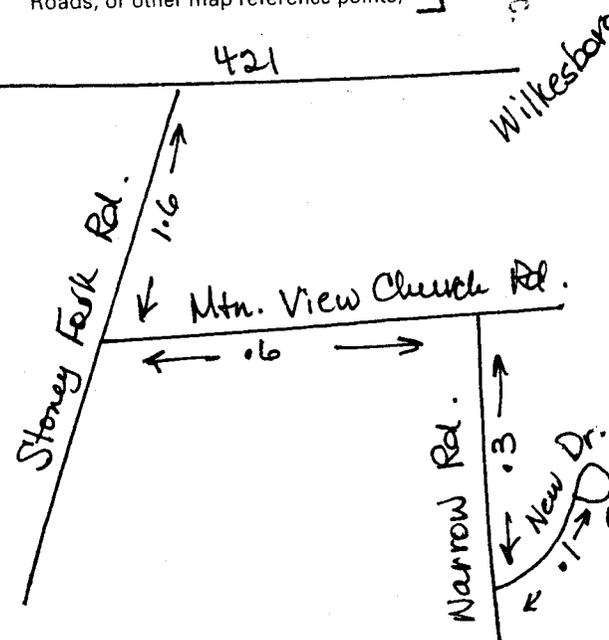

OS JMH  
 REFER TO DIVISION/PHD  
 WATER PROTECTION SEC.  
 PH 11/17

**FOR OFFICE USE ONLY**  
 Quad No: \_\_\_\_\_  
 Serial No. \_\_\_\_\_

Steven Price  
 SIGNATURE OF PERSON CONSTRUCTING THE WELL  
 DATE 12-10-04  
 Submit original to Division of Water Quality, Groundwater Section within 30 days  
 GW-1 REV. 12/99