

WS

306015

WELL CONSTRUCTION RECORD

040593-2

WELL CONTRACTOR: Dewey Wright Well Pump Co., Inc.
 WELL CONTRACTOR CERTIFICATION #: 2797
 STATE WELL CONSTRUCTION PERMIT#: Jerry Wilson

1. WELL USE (Check Applicable Box): Residential Municipal Industrial Agricultural Monitoring
 Recovery Heat Pump Water Injection Other If Other, List Use: _____

2. WELL LOCATION: (Show sketch of the location below)
 Nearest Town: BOONE County: WATAUGA
GLEN FOREST OFF LAUREL FORK RD. OFF BAIRDS CR
(Road Name and Numbers, Community, or Subdivision and Lot No.)

RECEIVED
 N.C. DEPT. OF ENVIRONMENT & NATURAL RESOURCES
 JAN 31 2005
 Winston-Salem
 Regional Office

3. DATE DRILLED 11/24/2004
 4. TOTAL DEPTH 465
 5. CUTTINGS COLLECTED YES NO
 6. DOES WELL REPLACE EXISTING WELL? YES NO
 7. STATIC WATER LEVEL Below Top of Casing: 80 FT.
(Use "+" if Above Top of Casing)

DRILLING LOG		DEPTH	Formation Description
From	To		
0	50		DIRT SHALE GRANITE
50	100		GRANITE QUARTZ
100	101		QUARTZ SHALE
101	420		GRANITE QUARTZ
420	421		QUARTZ
421	465		GRANITE QUARTZ

9. TOP OF CASING IS 1 FT. Above Land Surface*
*Top of casing terminated at/or below land surface requires a variance in accordance with 15A NCAC 26.0118
 10. YIELD (gpm): 8.5 METHOD OF TEST: Air
2.00 gpm 100-101 8.50 gpm 420-421
 11. WATER ZONES (depth): 0.00 gpm 0.00 gpm
 12. CHLORINATION: Type HTH Amount 76

13. CASING:

From	Depth	To	Diameter	Wall Thickness or Weight/Ft.	Material
0		57	6 1/8	.350	PVC

14. GROUT:

From	Depth	To	Material	Method
0		20	Cement	Gravity Flow


15. SCREEN:

From	Depth	To	Diameter	Slot Size	Material

16. SAND/GRAVEL PACK:

From	Depth	To	Size	Material

17. REMARKS: _____
 I DO HEREBY CERTIFY THAT THIS WELL WAS CONSTRUCTED IN ACCORDANCE WITH 15A NCAC 2C, WELL CONSTRUCTION STANDARDS, AND THAT A COPY OF THIS RECORD HAS BEEN PROVIDED TO THE WELL OWNER.

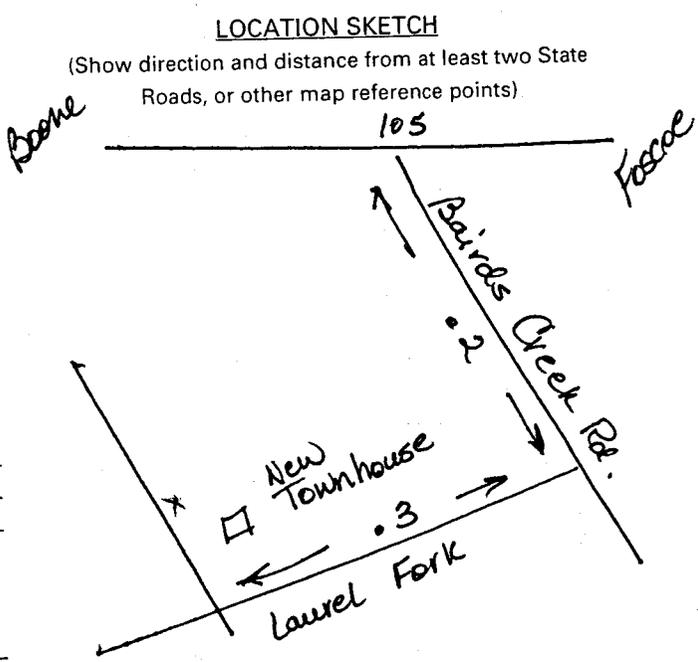

RECEIVED/DEPT. OF ENVIRONMENT & NATURAL RESOURCES
 JUN - 3 AM 11:18

Wayne Wilson 12-15-2004
 SIGNATURE OF PERSON CONSTRUCTING THE WELL DATE
 Submit original to Division of Water Quality, Groundwater Section within 30 days
 GW-1 REV. 12/99

FOR OFFICE USE ONLY
 Quad No: _____
 Serial No: _____