

W 306375

WELL CONSTRUCTION RECORD

040380

WELL CONTRACTOR: Dewey Wright Well Pump Co., Inc.
 WELL CONTRACTOR CERTIFICATION #: 2878
 STATE WELL CONSTRUCTION PERMIT#: Steve Price

RECEIVED
 N.C. Dept. of ENVIRONMENT

1. WELL USE (Check Applicable Box): Residential Municipal Industrial Agricultural Monitoring
 Recovery Heat Pump Water Injection Other If Other, List Use: JAN 25 2005

2. WELL LOCATION: (Show sketch of the location below)
 Nearest Town: BOONE County: WATAUGA
N. PINE RUN RD. OFF 421
(Road Name and Numbers, Community, or Subdivision and Lot No.)

Winston-Salem
 Regional Office

3.
 4. DATE DRILLED 12/29/2004
 5. TOTAL DEPTH 245
 6. CUTTINGS COLLECTED YES NO
 7. DOES WELL REPLACE EXISTING WELL? YES NO
 8. STATIC WATER LEVEL Below Top of Casing: 80 FT.
(Use "+" if Above Top of Casing)

DRILLING LOG		DEPTH
From	To	Formation Description
0	36	DIRT
36	70	GRANITE
70	71	QUARTZ
71	180	GRANITE
180	181	QUARTZ
181	230	GRANITE
230	231	QUARTZ
231	245	GRANITE

If additional space is needed use back of form

9. TOP OF CASING IS 1 FT. Above Land Surface*
*Top of casing terminated at/or below land surface requires a variance in accordance with 15A NCAC 2C.0118
 10. YIELD (gpm): 2.5 METHOD OF TEST Air
 11. WATER ZONES (depth): 0.50 gpm 70-71 1.00 gpm 180-181
1.00 gpm 230-231 0.00 gpm

12. CHLORINATION: Type HTH Amount 35

13. CASING:

From	Depth	To	Diameter	Wall Thickness or Weight/Ft.	Material
0		42	6 1/8	.350	PVC
From	To	Ft.			
From	To	Ft.			

LOCATION SKETCH
 (Show direction and distance from at least two State Roads, or other map reference points)

14. GROUT:

From	Depth	To	Material	Method
0		20	Cement	Gravity Flow
From	To	Ft.		
From	To	Ft.		


15. SCREEN:

From	Depth	To	Diameter	Slot Size	Material
From	To	Ft.	in.	in.	
From	To	Ft.	in.	in.	
From	To	Ft.	in.	in.	

16. SAND/GRAVEL PACK:

From	Depth	To	Size	Material
From	To	Ft.		
From	To	Ft.		

17. REMARKS:
 I DO HEREBY CERTIFY THAT THIS WELL WAS CONSTRUCTED IN ACCORDANCE WITH 15A NCAC 2C, WELL CONSTRUCTION STANDARDS, AND THAT A COPY OF THIS RECORD HAS BEEN PROVIDED TO THE WELL OWNER.

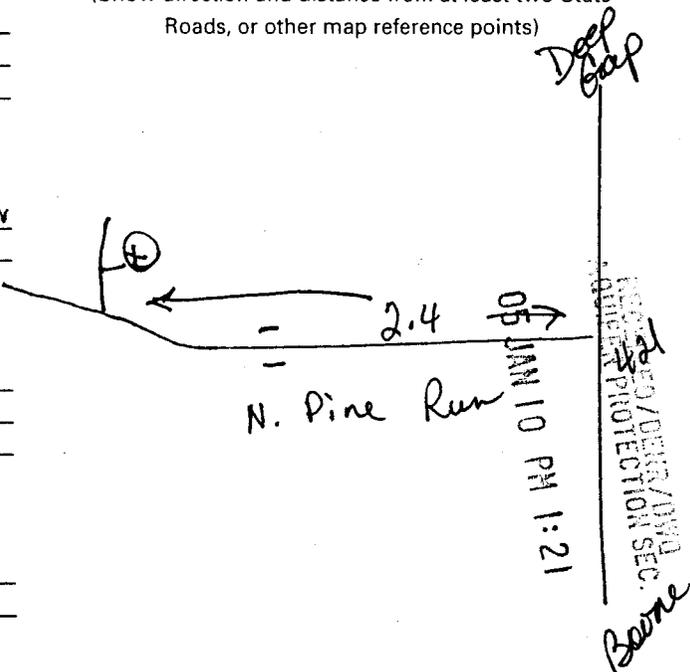

Steven Price 1-5-05
 SIGNATURE OF PERSON CONSTRUCTING THE WELL DATE

FOR OFFICE USE ONLY
 Quad No. _____
 Serial No. _____