

306387

WELL CONSTRUCTION RECORD

WELL CONTRACTOR: Dewey Wright Well Pump Co., Inc.
 WELL CONTRACTOR CERTIFICATION #: 2780
 STATE WELL CONSTRUCTION PERMIT#: Keith Presnell

040640

1. WELL USE (Check Applicable Box): Residential Municipal Industrial Agricultural Monitoring
 Recovery Heat Pump Water Injection Other If Other, List Use: _____

2. WELL LOCATION: (Show sketch of the location below)
 Nearest Town: BOONE County: WATAUGA
MILTON GRAGG RD OFF BROWNS CHAPEL RD. OFF OL
(Road Name and Numbers, Community, or Subdivision and Lot No.)

RECEIVED
 N.C. DEPT. OF ENVR
 JAN 25 2005

3. DATE DRILLED 12/29/2004
 4. TOTAL DEPTH 300
 5. CUTTINGS COLLECTED YES NO
 6. DOES WELL REPLACE EXISTING WELL? YES NO
 7. STATIC WATER LEVEL Below Top of Casing: 40 FT.
(Use "+" if Above Top of Casing)

DRILLING LOG		DEPTH	FORMATION DESCRIPTION
From	To		
0	90		DIRT SAND
90	190		GRANITE
190	193		QUARTZ
193	235		GRANITE
235	238		QUARTZ
238	300		GRANITE

9. TOP OF CASING IS 1 FT. Above Land Surface*
*Top of casing terminated at/or below land surface requires a variance in accordance with 15A NCAC 2C.0118
 10. YIELD (gpm): 30 METHOD OF TEST Air
 11. WATER ZONES (depth): 2.00 gpm 90-190 28.00 gpm 193-235
0.00 gpm 0.00 gpm
 12. CHLORINATION: Type HTH Amount 54

13. CASING:

From	Depth	To	Diameter	Wall Thickness or Weight/Ft.	Material
0		103	6 1/8	.350	PVC
From	To	Ft.			
From	To	Ft.			

LOCATION SKETCH
 (Show direction and distance from at least two State Roads, or other map reference points)

14. GROUT:

From	Depth	To	Material	Method
0		20	Cement	Gravity Flow
From	To	Ft.		


15. SCREEN:

From	Depth	To	Diameter	Slot Size	Material
From	To	Ft.	in.	in.	
From	To	Ft.	in.	in.	
From	To	Ft.	in.	in.	

16. SAND/GRAVEL PACK:

From	Depth	To	Size	Material
From	To	Ft.		
From	To	Ft.		

17. REMARKS:
 I DO HEREBY CERTIFY THAT THIS WELL WAS CONSTRUCTED IN ACCORDANCE WITH 15A NCAC 2C, WELL CONSTRUCTION STANDARDS, AND THAT A COPY OF THIS RECORD HAS BEEN PROVIDED TO THE WELL OWNER.
Keith C Presnell 1-5-2005

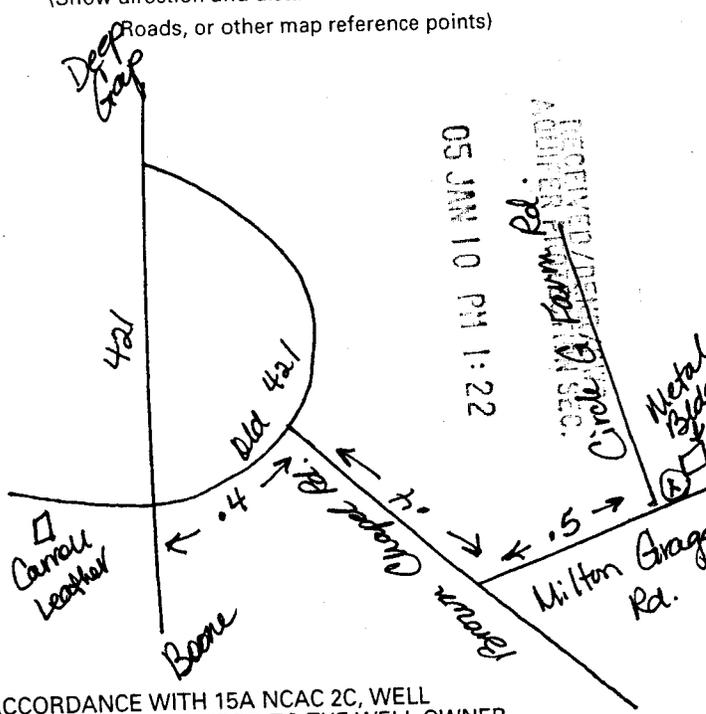

FOR OFFICE USE ONLY
 Quad No: _____