

WS
 307438

WELL CONSTRUCTION RECORD

050008

WELL CONTRACTOR: Dewey Wright Well Pump Co., Inc.
 WELL CONTRACTOR CERTIFICATION #: 2878
 STATE WELL CONSTRUCTION PERMIT#: Steve Price

1. WELL USE (Check Applicable Box): Residential Municipal Industrial Agricultural Monitoring
 Recovery Heat Pump Water Injection Other If Other, List Use: N.C.D.

2. WELL LOCATION: (Show sketch of the location below)
 Nearest Town: BOONE County: WATAUGA
OFF POTTER AVE OFF CHESTNUT GROVE RD. OFF HW
(Road Name and Numbers, Community, or Subdivision and Lot No.)

MAR 14 2005
 WILSON
 DRILLING LOG

3. DRILLING LOG DEPTH
- | From | To | Formation Description |
|------|-----|-----------------------|
| 0 | 35 | DIRT/MUD |
| 35 | 180 | GRANITE |
| 180 | 181 | GRANITE |
| 181 | 270 | GRANITE |
| 270 | 271 | QUARTZ |
| 271 | 305 | GRANITE |
4. DATE DRILLED 1/6/2005
 5. TOTAL DEPTH 305
 6. CUTTINGS COLLECTED YES NO
 7. DOES WELL REPLACE EXISTING WELL? YES NO
 8. STATIC WATER LEVEL Below Top of Casing: 30 FT.
(Use "+" if Above Top of Casing)
 9. TOP OF CASING IS 1 FT. Above Land Surface*
*Top of casing terminated at/or below land surface requires a variance in accordance with 15A NCAC 2C.0118
 10. YIELD (gpm): 1 METHOD OF TEST Air
 11. WATER ZONES (depth): 0.50 gpm 180-181 0.50 gpm 270-271
0.00 gpm 0.00 gpm
 12. CHLORINATION: Type HTH Amount 58

If additional space is needed use back of form


13. CASING:
- | From | To | Depth | Diameter | Wall Thickness or Weight/Ft. | Material |
|------|----|-------|----------|------------------------------|----------|
| 0 | 40 | Ft. | 6 1/8 | .350 | PVC |
| From | To | Ft. | | | |
| From | To | Ft. | | | |

14. GROUT:
- | From | To | Depth | Material | Method |
|------|----|-------|----------|--------------|
| 0 | 20 | Ft. | Cement | Gravity Flow |
| From | To | Ft. | | |

15. SCREEN:
- | From | To | Depth | Diameter | Slot Size | Material |
|------|----|-------|----------|-----------|----------|
| From | To | Ft. | in. | in. | |
| From | To | Ft. | in. | in. | |
| From | To | Ft. | in. | in. | |

16. SAND/GRAVEL PACK:
- | From | To | Depth | Size | Material |
|------|----|-------|------|----------|
| From | To | Ft. | | |
| From | To | Ft. | | |

17. REMARKS:

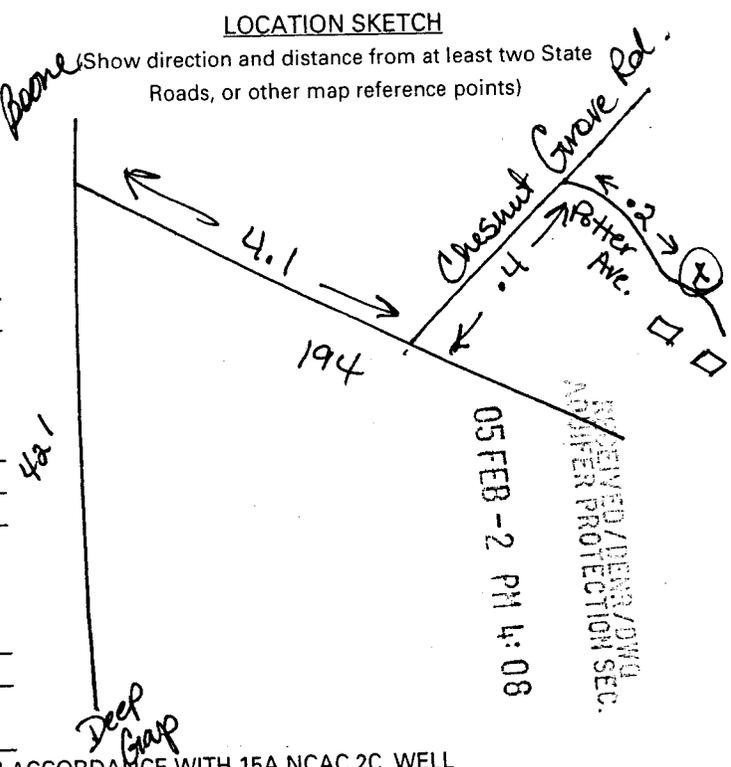

I DO HEREBY CERTIFY THAT THIS WELL WAS CONSTRUCTED IN ACCORDANCE WITH 15A NCAC 2C, WELL CONSTRUCTION STANDARDS, AND THAT A COPY OF THIS RECORD HAS BEEN PROVIDED TO THE WELL OWNER.

Steven Price 1-30-05
 SIGNATURE OF PERSON CONSTRUCTING THE WELL DATE

Submit original to Division of Water Quality, Groundwater Section within 30 days
 GW-1 REV. 12/99

FOR OFFICE USE ONLY
 Quad No: _____