

WS  
 307440

**WELL CONSTRUCTION RECORD**

WELL CONTRACTOR: Dewey Wright Well Pump Co., Inc.  
 WELL CONTRACTOR CERTIFICATION #: 2878  
 STATE WELL CONSTRUCTION PERMIT#: Steve Price

050007

1. WELL USE (Check Applicable Box): Residential  Municipal  Industrial  Agricultural  Monitoring   
 Recovery  Heat Pump Water Injection  Other  If Other, List Use: \_\_\_\_\_

2. WELL LOCATION: (Show sketch of the location below)  
 Nearest Town: BLOWING ROCK County: WATAUGA  
GRANDVIEW DR. OFF GEORGE HAYES RD. OFF SAMP  
(Road Name and Numbers, Community, or Subdivision and Lot No.)

3. DRILLING LOG

From	To	DEPTH Formation Description
0	30	DIRT
30	130	GRANITE
130	131	QUARTZ
131	370	GRANITE
370	372	QUARTZ
372	405	GRANITE

4. DATE DRILLED 1/20/2005  
 5. TOTAL DEPTH 405  
 6. CUTTINGS COLLECTED YES  NO   
 7. DOES WELL REPLACE EXISTING WELL? YES  NO   
 8. STATIC WATER LEVEL Below Top of Casing: 80 FT.  
(Use "+" if Above Top of Casing)

9. TOP OF CASING IS 1 FT. Above Land Surface\*  
\*Top of casing terminated at/or below land surface requires a variance in accordance with 15A NCAC 2C.0118  
 10. YIELD (gpm): 7 METHOD OF TEST Air  
 11. WATER ZONES (depth): 4.00 gpm 130-131 3.00 gpm 370-372  
0.00 gpm 0.00 gpm  
 12. CHLORINATION: Type HTH Amount 70

13. CASING:

From	Depth	Diameter	Wall Thickness or Weight/Ft.	Material
0	To 35 Ft.	8 1/8	.350	PUMPED
From	To	Ft.		
From	To	Ft.		

LOCATION SKETCH  
 (Show direction and distance from at least two State Roads, or other map reference points)

14. GROUT:

From	Depth	Material	Method
0	To 20 Ft.	Cement	Gravity Flow
From	To	Ft.	


15. SCREEN:

From	Depth	Diameter	Slot Size	Material
From	To	Ft.	in.	in.
From	To	Ft.	in.	in.
From	To	Ft.	in.	in.

16. SAND/GRAVEL PACK:

From	Depth	Size	Material
From	To	Ft.	
From	To	Ft.	

17. REMARKS:

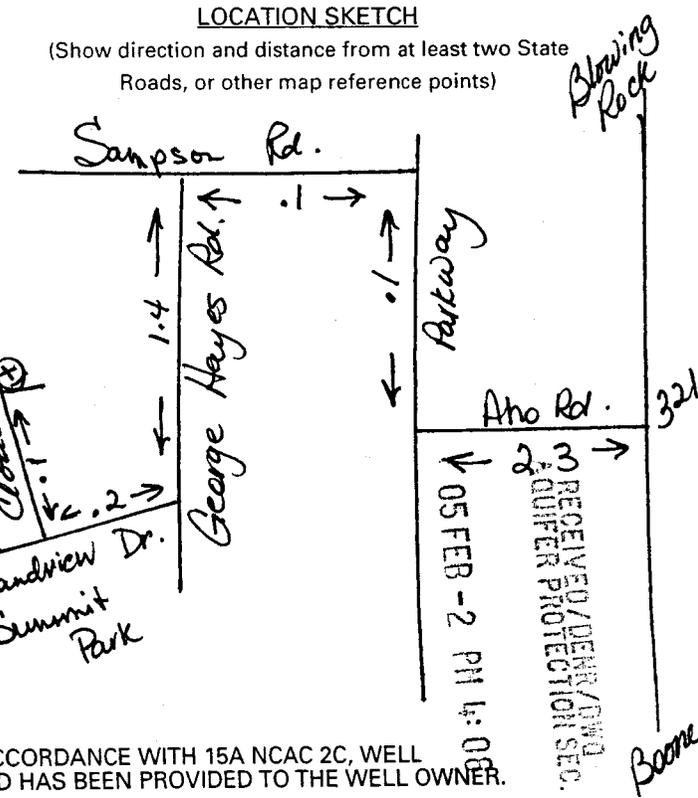

I DO HEREBY CERTIFY THAT THIS WELL WAS CONSTRUCTED IN ACCORDANCE WITH 15A NCAC 2C, WELL CONSTRUCTION STANDARDS, AND THAT A COPY OF THIS RECORD HAS BEEN PROVIDED TO THE WELL OWNER.

Steven Price 1-30-05  
 SIGNATURE OF PERSON CONSTRUCTING THE WELL DATE

Submit original to Division of Water Quality, Groundwater Section within 30 days

**FOR OFFICE USE ONLY**  
 Quad No: \_\_\_\_\_  
 Serial No. \_\_\_\_\_