

WELL CONSTRUCTION RECORD

WELL CONTRACTOR: Dewey Wright Well Pump Co. **309059**
 WELL CONTRACTOR CERTIFICATION #: 2878
 STATE WELL CONSTRUCTION PERMIT#: Steve Price

050010

1. WELL USE (Check Applicable Box): Residential Municipal Industrial Agricultural Monitoring
 Recovery Heat Pump Water Injection Other If Other, List Use: N.C. Dr. 1

2. WELL LOCATION: (Show sketch of the location below)
 Nearest Town: BOONE County: WATAUGA
PRIVATE DR. OFF HWY 104 OFF BROADSTONE RD. OF
(Road Name and Numbers, Community, or Subdivision and Lot No.)

RECEIVED
 APR 04 2005
 Winston-Salem
 Regional Office

3. DRILLING LOG
- | From | To | Formation Description |
|------|-----|-----------------------|
| 0 | 65 | SAND/MUD/GRAVEL |
| 65 | 90 | GRANITE |
| 90 | 91 | GRANITE |
| 91 | 115 | GRANITE |
| 115 | 118 | QUARTZ |
| 118 | 125 | GRANITE |
4. DATE DRILLED 1/10/2005
 5. TOTAL DEPTH 125
 6. CUTTINGS COLLECTED YES NO
 7. DOES WELL REPLACE EXISTING WELL? YES NO
 8. STATIC WATER LEVEL Below Top of Casing: 20 FT.
(Use "+" if Above Top of Casing)

9. TOP OF CASING IS 1 FT. Above Land Surface*
*Top of casing terminated at/or below land surface requires a variance in accordance with 15A NCAC 2C.0118
 10. YIELD (gpm): 30 METHOD OF TEST Air
 11. WATER ZONES (depth): 4.00 gpm 90-91 26.00 gpm 115-118
0.00 gpm 0.00 gpm
 12. CHLORINATION: Type HTH Amount 22


13. CASING:
- | From | To | Depth | Diameter | Wall Thickness or Weight/Ft. | Material |
|------|----|-------|----------|------------------------------|----------|
| 0 | 70 | Ft. | 8 1/8 | 350 | PVC |
| 70 | | Ft. | | | |
| | | Ft. | | | |

14. GROUT:
- | From | To | Depth | Material | Method |
|------|----|-------|----------|--------------|
| 0 | 20 | Ft. | Cement | Gravity Flow |
| 20 | | Ft. | | |

15. SCREEN:
- | From | To | Depth | Diameter | Slot Size | Material |
|------|----|-------|----------|-----------|----------|
| | | Ft. | in. | in. | |
| | | Ft. | in. | in. | |
| | | Ft. | in. | in. | |

16. SAND/GRAVEL PACK:
- | From | To | Depth | Size | Material |
|------|----|-------|------|----------|
| | | Ft. | | |
| | | Ft. | | |

17. REMARKS:

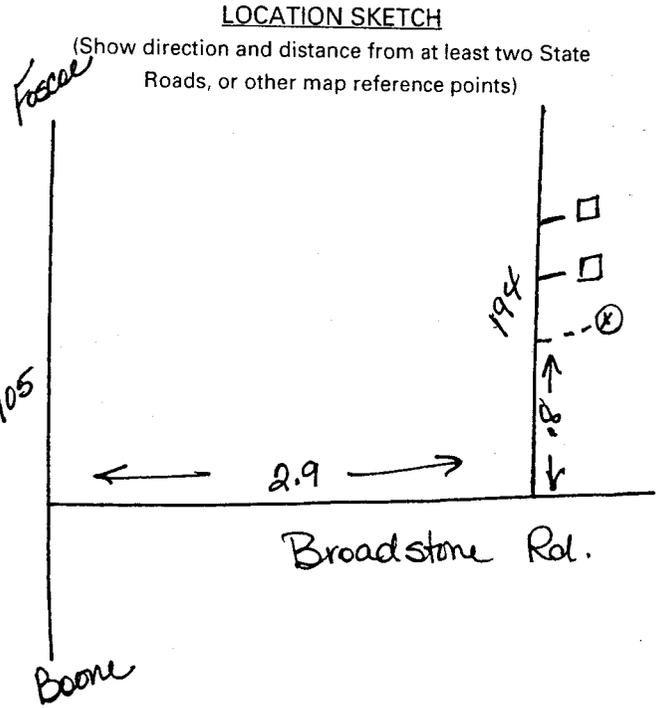

RECORD BY CENTRAL FILED
 MAR 24 05

I DO HEREBY CERTIFY THAT THIS WELL WAS CONSTRUCTED IN ACCORDANCE WITH 15A NCAC 2C, WELL CONSTRUCTION STANDARDS, AND THAT A COPY OF THIS RECORD HAS BEEN PROVIDED TO THE WELL OWNER.

Steven Price 3-18-05

FOR OFFICE USE ONLY
 Quad No: _____
 Serial No. _____

SIGNATURE OF PERSON CONSTRUCTING THE WELL DATE
 Submit original to Division of Water Quality, Groundwater Section within 30 days