

309083

WELL CONSTRUCTION RECORD

WELL CONTRACTOR: Dewey Wright Well Pump Co., Inc.
 WELL CONTRACTOR CERTIFICATION #: 2645
 STATE WELL CONSTRUCTION PERMIT#: Dewey Wright

050084

1. WELL USE (Check Applicable Box): Residential Municipal Industrial Agricultural Monitoring
 Recovery Heat Pump Water Injection Other If Other, List Use: RECEIVED

N.C. Dept. of ENR

2. WELL LOCATION: (Show sketch of the location below)
 Nearest Town: BOONE County: WATAUGA

APR 04 2005

HWY 194 OFF HWY 121
 (Road Name and Numbers, Community, or Subdivision and Lot No.)

DRILLING LOG		DEPTH	Formation Description
From	To		
0	60		MUD & GRAVEL
60	71		GRANITE
71	72		SHALE
72	88		GRANITE
88	89		SHALE
89	105		GRANITE

REC'D BY CENTRAL FILES
MAR 24 05

Winston-Salem Regional Office

3. DATE DRILLED 3/7/2005
 4. TOTAL DEPTH 105
 5. CUTTINGS COLLECTED YES NO
 6. DOES WELL REPLACE EXISTING WELL? YES NO
 7. STATIC WATER LEVEL Below Top of Casing: 10 FT.
 (Use "+" if Above Top of Casing)

8. TOP OF CASING IS 1 FT. Above Land Surface*
 *Top of casing terminated at/or below land surface requires a variance in accordance with 15A NCAC 2C.0118
 9. YIELD (gpm): 50 METHOD OF TEST Air
 10. WATER ZONES (depth): 0.00 gpm 71-72 40.00 gpm 88-89
0.00 gpm 0.00 gpm
 11. CHLORINATION: Type HTH Amount 20


If additional space is needed use back of form

13. CASING:

Depth	Diameter	Wall Thickness or Weight/Ft.	Material
From <u>0</u> To <u>63</u> Ft.	<u>6 1/8</u>	<u>350</u>	<u>PVC</u>
From _____ To _____ Ft.	_____	_____	_____
From _____ To _____ Ft.	_____	_____	_____

LOCATION SKETCH

(Show direction and distance from at least two State Roads, or other map reference points)

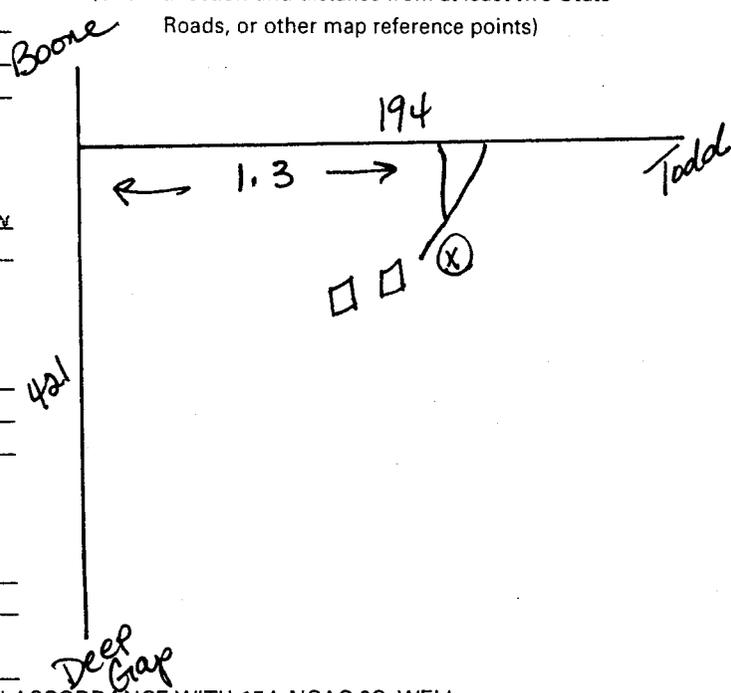

14. GROUT:

Depth	Material	Method
From <u>0</u> To <u>20</u> Ft.	<u>Cement</u>	<u>Gravity Flow</u>
From _____ To _____ Ft.	_____	_____

15. SCREEN:

Depth	Diameter	Slot Size	Material
From _____ To _____ Ft.	_____ in.	_____ in.	_____
From _____ To _____ Ft.	_____ in.	_____ in.	_____
From _____ To _____ Ft.	_____ in.	_____ in.	_____

16. SAND/GRAVEL PACK:

Depth	Size	Material
From _____ To _____ Ft.	_____	_____
From _____ To _____ Ft.	_____	_____

17. REMARKS: I DO HEREBY CERTIFY THAT THIS WELL WAS CONSTRUCTED IN ACCORDANCE WITH 15A NCAC 2C, WELL CONSTRUCTION STANDARDS, AND THAT A COPY OF THIS RECORD HAS BEEN PROVIDED TO THE WELL OWNER.

Dewey Wright Jr.
 SIGNATURE OF PERSON CONSTRUCTING THE WELL

DATE

Submit original to Division of Water Quality, Groundwater Section within 30 days

FOR OFFICE USE ONLY

Quad No: _____

Serial No. _____