

310849

WELL CONSTRUCTION RECORD

WELL CONTRACTOR: Dewey Wright Well Pump Co., Inc.
 WELL CONTRACTOR CERTIFICATION #: 2878
 STATE WELL CONSTRUCTION PERMIT#: Steve Price

050100

1. WELL USE (Check Applicable Box): Residential Municipal Industrial Agricultural Monitoring
 Recovery Heat Pump Water Injection Other If Other, List Use: NR

2. WELL LOCATION: (Show sketch of the location below)
 Nearest Town: BOONE County: WATAUGA MAY 31 2005
LARRY WINKLER RD. OFF OLD HWY 421 OFF HWY 421
(Road Name and Numbers, Community, or Subdivision and Lot No.)

DRILLING LOG		DEPTH	FORMATION DESCRIPTION
From	To		
0	50		DIRT
50	370		GRANITE
370	371		GRANITE
371	430		GRANITE
430	431		GRANITE
431	445		GRANITE

RECORDED BY CENTRAL FILES
MAY 13 05

If additional space is needed use back of form

3. DATE DRILLED 4/11/2005
 4. TOTAL DEPTH 445
 5. CUTTINGS COLLECTED YES NO
 6. DOES WELL REPLACE EXISTING WELL? YES NO
 7. STATIC WATER LEVEL Below Top of Casing: 200 FT.
(Use "+" if Above Top of Casing)

8. TOP OF CASING IS 1 FT. Above Land Surface*
*Top of casing terminated at/or below land surface requires a variance in accordance with 15A NCAC 2C.0118
 9. YIELD (gpm): 0.5 METHOD OF TEST Air
 10. WATER ZONES (depth): 0.25 gpm 370-371 0.25 gpm 430-431
0.00 gpm 0.00 gpm
 11. CHLORINATION: Type HTH Amount 49

13. CASING:

From	To	Depth	Diameter	Wall Thickness or Weight/Ft.	Material
0	55	Ft.	6 1/4	350	PVC
From	To	Ft.			
From	To	Ft.			

14. GROUT:

From	To	Depth	Material	Method
0	20	Ft.	Cement	Gravity Flow
From	To	Ft.		

15. SCREEN:


From	To	Depth	Diameter	Slot Size	Material
From	To	Ft.	in.	in.	
From	To	Ft.	in.	in.	
From	To	Ft.	in.	in.	

16. SAND/GRAVEL PACK:

From	To	Depth	Size	Material
From	To	Ft.		
From	To	Ft.		

17. REMARKS: _____
 I DO HEREBY CERTIFY THAT THIS WELL WAS CONSTRUCTED IN ACCORDANCE WITH 15A NCAC 2C. WELL CONSTRUCTION STANDARDS, AND THAT A COPY OF THIS RECORD HAS BEEN PROVIDED TO THE WELL OWNER.

LOCATION SKETCH
 (Show direction and distance from at least two State Roads or other map reference points)

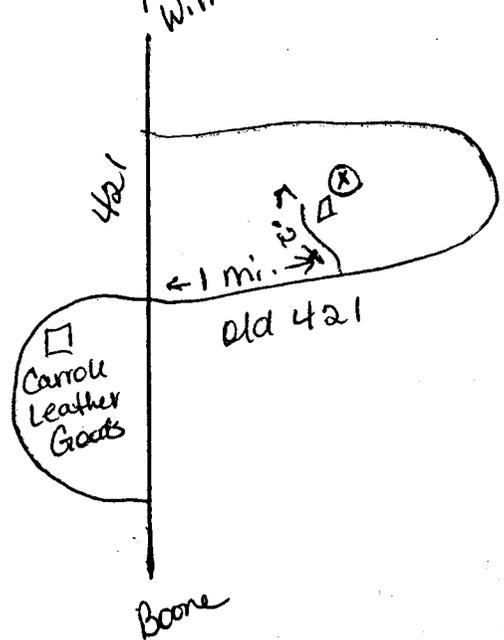

FOR OFFICE USE ONLY
 Quad No: _____

Steven Price 4-20-05
 SIGNATURE OF PERSON CONSTRUCTING THE WELL DATE
 Submit original to Division of Water Quality, Groundwater Section within 30 days GW-1 REV. 12/99