

WS100

310850

WELL CONSTRUCTION RECORD

WELL CONTRACTOR: Dewey Wright Well Pump Co., Inc.
 WELL CONTRACTOR CERTIFICATION #: 2888
 STATE WELL CONSTRUCTION PERMIT#: Leslie Reece

040405

1. WELL USE (Check Applicable Box): Residential Municipal Industrial Agricultural Monitoring
 Recovery Heat Pump Water Injection Other If Other, List Use: _____

2. WELL LOCATION: (Show sketch of the location below)
 Nearest Town: INVERSHIELD County: WATAUGA
ROCKY EXT OFF J.H. MCCLEAN RD. OFF 105
(Road Name and Numbers, Community, or Subdivision and Lot No.)

MAY 31 2005

Winston-Salem
 Regional Office

3. _____
 4. DATE DRILLED 3/31/2005
 5. TOTAL DEPTH 145
 6. CUTTINGS COLLECTED YES NO
 7. DOES WELL REPLACE EXISTING WELL? YES NO
 8. STATIC WATER LEVEL Below Top of Casing: 10 FT.
(Use "+" if Above Top of Casing)

DRILLING LOG		Formation Description
From	To	
0	81	MUD GRAVEL
81	93	GRANITE
93	94	SHALE
94	115	GRANITE
115	117	SHALE
117	145	GRANITE

RECD BY CENTRAL FILE
MAY 13 05


9. TOP OF CASING IS 1 FT. Above Land Surface*
*Top of casing terminated at/or below land surface requires a variance in accordance with 15A NCAC 2C.0118
 10. YIELD (gpm): 50 METHOD OF TEST Air
 11. WATER ZONES (depth): 10.00 gpm 93-94 40.00 gpm 115-117
0.00 gpm 0.00 gpm
 12. CHLORINATION: Type HTH Amount 27

If additional space is needed use back of form

13. CASING:

From	Depth	To	Diameter	Wall Thickness or Weight/Ft.	Material
0		81	6 1/4	.188	GALV
_____		_____	_____	_____	_____
_____		_____	_____	_____	_____

LOCATION SKETCH
 (Show direction and distance from at least two State Roads, or other map reference points)

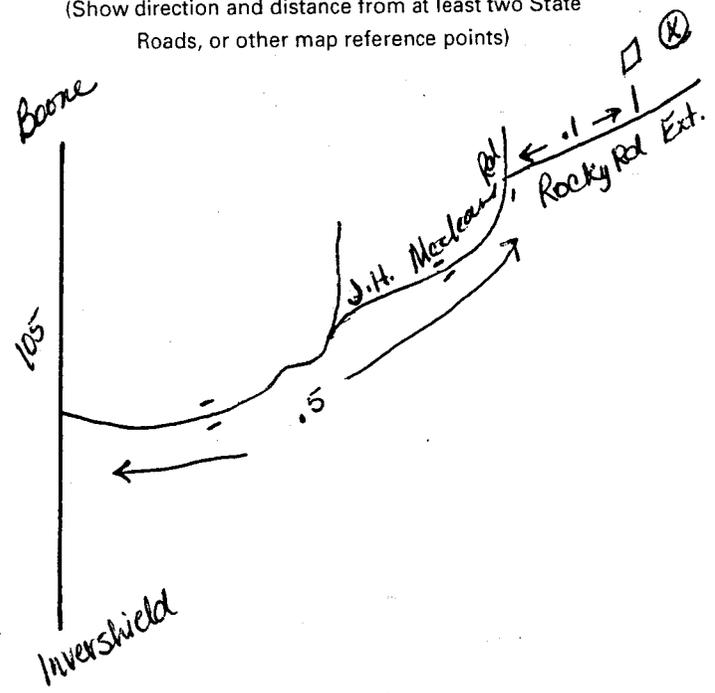

14. GROUT:

From	Depth	To	Material	Method
0		20	Cement	Gravity Flow
_____		_____	_____	_____

15. SCREEN:

From	Depth	To	Diameter	Slot Size	Material
_____		_____	_____	_____	_____
_____		_____	_____	_____	_____
_____		_____	_____	_____	_____

16. SAND/GRAVEL PACK:

From	Depth	To	Size	Material
_____		_____	_____	_____
_____		_____	_____	_____

17. REMARKS: _____

I DO HEREBY CERTIFY THAT THIS WELL WAS CONSTRUCTED IN ACCORDANCE WITH 15A NCAC 2C, WELL CONSTRUCTION STANDARDS, AND THAT A COPY OF THIS RECORD HAS BEEN PROVIDED TO THE WELL OWNER.

Wayne Reece

4-8-05

FOR OFFICE USE ONLY

Quad No: _____

Serial No: _____

SIGNATURE OF PERSON CONSTRUCTING THE WELL
 Submit original to Division of Water Quality, Groundwater Section within 30 days

DATE
 GW-1 REV. 12/99