

310858

**WELL CONSTRUCTION RECORD**

WELL CONTRACTOR: Dewey Wright Well Pump Co., Inc.  
 WELL CONTRACTOR CERTIFICATION #: 2878  
 STATE WELL CONSTRUCTION PERMIT#: Steve Price

050035

RECEIVED  
 N.C. Department of Environment and Natural Resources  
 MAY 31 2005  
 Winston-Salem  
 Regional Office

1. WELL USE (Check Applicable Box): Residential  Municipal  Industrial  Agricultural  Monitoring   
 Recovery  Heat Pump Water Injection  Other  If Other, List Use: \_\_\_\_\_

2. WELL LOCATION: (Show sketch of the location below)  
 Nearest Town: FOSCOE County: WATAUGA  
LAM'S WAY OFF REUBEN WALKER RD. OFF BAIRDS C  
(Road Name and Numbers, Community, or Subdivision and Lot No.)

DRILLING LOG		DEPTH	Formation Description
From	To		
0	35		DIRT
35	330		GRANITE
330	332		SHALE
332	370		GRANITE
370	371		QUARTZ
371	405		GRANITE

REC'D BY CENTRAL FILED  
MAY 13 05

3. DATE DRILLED 4/1/2005  
 4. TOTAL DEPTH 405  
 5. CUTTINGS COLLECTED YES  NO   
 6. DOES WELL REPLACE EXISTING WELL? YES  NO   
 7. STATIC WATER LEVEL Below Top of Casing: 200 FT.  
(Use "+" if Above Top of Casing)


9. TOP OF CASING IS 1 FT. Above Land Surface\*  
\*Top of casing terminated at/or below land surface requires a variance in accordance with 15A NCAC 2C.0118

10. YIELD (gpm): 1 METHOD OF TEST Air  
 11. WATER ZONES (depth): 0.50 gpm 330-332 0.50 gpm 370-371  
0.00 gpm 0.00 gpm  
 12. CHLORINATION: Type HTH Amount 43

13. CASING:  

From	To	Depth	Diameter	Wall Thickness or Weight/Ft.	Material
0	41	Ft.	6 1/8	.350	PVC
41	405	Ft.			

LOCATION SKETCH  
 (Show direction and distance from at least two State Roads, or other map reference points)

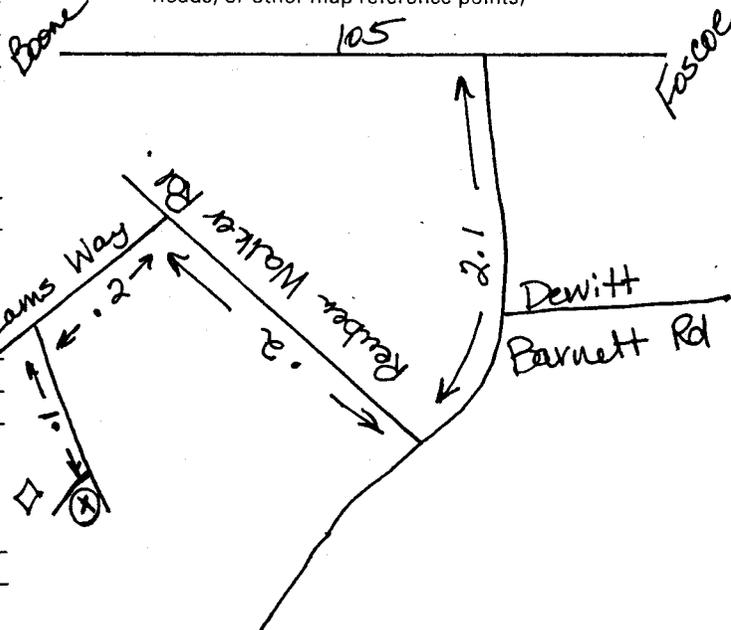

14. GROUT:  

From	To	Depth	Material	Method
0	20	Ft.	Cement	Gravity Flow
20	405	Ft.		

15. SCREEN:  

From	To	Depth	Diameter	Slot Size	Material
		Ft.	in.	in.	
		Ft.	in.	in.	
		Ft.	in.	in.	

16. SAND/GRAVEL PACK:  

From	To	Depth	Size	Material
		Ft.		
		Ft.		

17. REMARKS: \_\_\_\_\_  
 I DO HEREBY CERTIFY THAT THIS WELL WAS CONSTRUCTED IN ACCORDANCE WITH 15A NCAC 2C, WELL CONSTRUCTION STANDARDS, AND THAT A COPY OF THIS RECORD HAS BEEN PROVIDED TO THE WELL OWNER.

Steven Price 4-14-05  
 SIGNATURE OF PERSON CONSTRUCTING THE WELL DATE

Submit original to Division of Water Quality, Groundwater Section within 30 days  
 GW-1 REV. 12/99

FOR OFFICE USE ONLY  
 Quad No: \_\_\_\_\_  
 Serial No: \_\_\_\_\_