

312130

WELL CONSTRUCTION RECORD

WELL CONTRACTOR: Dewey Wright Well Pump Co., Inc.
 WELL CONTRACTOR CERTIFICATION #: 2681
 STATE WELL CONSTRUCTION PERMIT#: Steve Petty

050211

1. WELL USE (Check Applicable Box): Residential Municipal Industrial Agricultural Monitoring
 Recovery Heat Pump Water Injection Other If Other, List Use: _____

2. WELL LOCATION: (Show sketch of the location below)
 Nearest Town: BLOWING ROCK County: WATAUGA
PRICE STREET OFF 221 OFF 321 BUSINESS OFF 321
(Road Name and Numbers, Community, or Subdivision and Lot No.)

3. _____
 4. DATE DRILLED 5/16/2005
 5. TOTAL DEPTH 165
 6. CUTTINGS COLLECTED YES NO
 7. DOES WELL REPLACE EXISTING WELL? YES NO
 8. STATIC WATER LEVEL Below Top of Casing: 40 FT.
(Use "+" if Above Top of Casing)

DRILLING LOG		DEPTH
From	To	Formation Description
0	100	DIRT
100	130	GRANITE
130	132	SHALE
132	148	GRANITE
146	147	SHALE
147	165	GRANITE

9. TOP OF CASING IS 1 FT. Above Land Surface*
*Top of casing terminated at/or below land surface requires a variance in accordance with 15A NCAC 2C.0118
 10. YIELD (gpm): 12 METHOD OF TEST Air
 11. WATER ZONES (depth): 5.00 gpm 130-132 7.00 gpm 146-147
0.00 gpm 0.00 gpm
 12. CHLORINATION: Type HTH Amount 26

If additional space is needed use back of form.

13. CASING:

From	To	Depth	Diameter	Wall Thickness or Weight/Ft.	Material
0	110	Ft.	6 1/8	350	PVC
From	To	Ft.			
From	To	Ft.			

LOCATION SKETCH (Show direction and distance from at least two State Roads, or other map reference points)

JUN 15 2005
 RECEIVED BY ORIGINAL FILED

Blowing Rock

14. GROUT:

From	To	Depth	Material	Method
0	20	Ft.	Cement	Gravity Flow
From	To	Ft.		


15. SCREEN:

From	To	Depth	Diameter	Slot Size	Material
From	To	Ft.	in.	in.	
From	To	Ft.	in.	in.	
From	To	Ft.	in.	in.	

16. SAND/GRAVEL PACK:

From	To	Depth	Size	Material
From	To	Ft.		
From	To	Ft.		

17. REMARKS: _____
 I DO HEREBY CERTIFY THAT THIS WELL WAS CONSTRUCTED IN ACCORDANCE WITH 15A NCAC 2C, WELL CONSTRUCTION STANDARDS, AND THAT A COPY OF THIS RECORD HAS BEEN PROVIDED TO THE WELL OWNER.

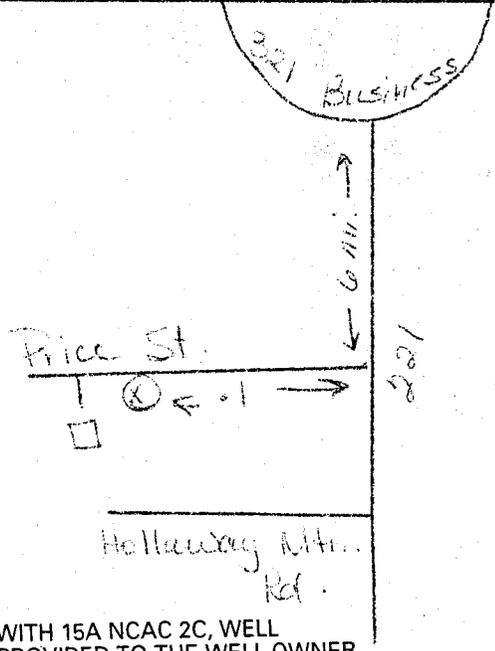

FOR OFFICE USE ONLY
 Quad No: _____
 Serial No. _____

Signature: Steve Petty DATE: 5-26-05
 SIGNATURE OF PERSON CONSTRUCTING THE WELL
 Submit original to Division of Water Quality, Groundwater Section within 30 days
 GW-1 REV. 12/99