

312134

WELL CONSTRUCTION RECORD

WELL CONTRACTOR: Dewey Wright Well Pump Co., Inc.
 WELL CONTRACTOR CERTIFICATION #: 2681
 STATE WELL CONSTRUCTION PERMIT#: Steve Petty

050121

1. WELL USE (Check Applicable Box): Residential Municipal Industrial Agricultural Monitoring
 Recovery Heat Pump Water Injection Other If Other, List Use: _____

2. WELL LOCATION: (Show sketch of the location below)
 Nearest Town: BLOWING ROCK County: WATAUGA
ALGONQUIN DR. OFF GOSHEN DR. OFF GEORGE HAYE
(Road Name and Numbers, Community, or Subdivision and Lot No.)

3. _____
 4. DATE DRILLED 5/3/2005
 5. TOTAL DEPTH 405
 6. CUTTINGS COLLECTED YES NO
 7. DOES WELL REPLACE EXISTING WELL? YES NO
 8. STATIC WATER LEVEL Below Top of Casing: 30 FT.
(Use "+" if Above Top of Casing)

DRILLING LOG		DEPTH
From	To	Formation Description
0	15	DIRT
15	85	GRANITE
85	86	SHALE
86	370	GRANITE
370	372	SHALE
372	405	GRANITE

REC'D BY CENTRAL FILED
JUN - 2 0 05

9. TOP OF CASING IS 1 FT. Above Land Surface*
*Top of casing terminated at/or below land surface requires a variance in accordance with 15A NCAC 2C.0118
 10. YIELD (gpm): 10 METHOD OF TEST Air
 11. WATER ZONES (depth): 2.00 gpm 85-86 8.00 gpm 370-372
0.00 gpm 0.00 gpm
 12. CHLORINATION: Type HTH Amount 74

13. CASING:

From	Depth	To	Diameter	Wall Thickness or Weight/Ft.	Material
0		21	6 1/4	.185	GALV
_____		_____	_____	_____	_____
_____		_____	_____	_____	_____

14. GROUT:

From	Depth	To	Material	Method
0		20	Cement	Gravity Flow
_____		_____	_____	_____


15. SCREEN:

From	Depth	To	Diameter	Slot Size	Material
_____		_____	_____	_____	_____
_____		_____	_____	_____	_____
_____		_____	_____	_____	_____

16. SAND/GRAVEL PACK:

From	Depth	To	Size	Material
_____		_____	_____	_____
_____		_____	_____	_____

17. REMARKS: _____
 I DO HEREBY CERTIFY THAT THIS WELL WAS CONSTRUCTED IN ACCORDANCE WITH 15A NCAC 2C, WELL CONSTRUCTION STANDARDS, AND THAT A COPY OF THIS RECORD HAS BEEN PROVIDED TO THE WELL OWNER.

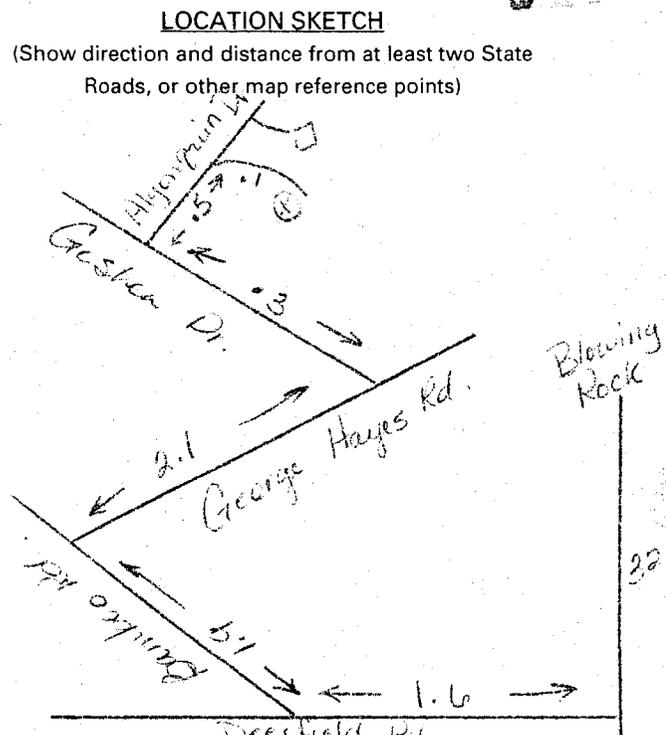

Steve Petty
 5-26-05

FOR OFFICE USE ONLY
 Quad No: _____
 Serial No. _____

SIGNATURE OF PERSON CONSTRUCTING THE WELL _____ DATE _____
 Submit original to Division of Water Quality, Groundwater Section within 30 days
 GW-1 REV. 12/99