

312140

WELL CONSTRUCTION RECORD

WELL CONTRACTOR: Dewey Wright Well Pump Co., Inc.
 WELL CONTRACTOR CERTIFICATION #: 2881
 STATE WELL CONSTRUCTION PERMIT#: Steve Petty

050002

1. WELL USE (Check Applicable Box): Residential Municipal Industrial Agricultural Monitoring
 Recovery Heat Pump Water Injection Other If Other, List Use: _____

2. WELL LOCATION: (Show sketch of the location below)
 Nearest Town: BOONE County: WATAUGA
TOUCHDOWN DR. OFF DOGWOOD RD. OFF CORBETT
(Road Name and Numbers, Community, or Subdivision and Lot No.)

DRILLING LOG		DEPTH
From	To	Formation Description
0	45	DIRT
45	90	GRANITE
90	91	SHALE
91	370	GRANITE
370	372	SHALE
372	405	GRANITE

JUN-2-05
 RECORD BY CENTRAL FILES

If additional space is needed use back of form

3. DATE DRILLED 5/6/2005
 4. TOTAL DEPTH 405
 5. CUTTINGS COLLECTED YES NO
 6. DOES WELL REPLACE EXISTING WELL? YES NO
 7. STATIC WATER LEVEL Below Top of Casing: 40 FT.
(Use "+" if Above Top of Casing)

8. TOP OF CASING IS 1 FT. Above Land Surface*
*Top of casing terminated at/or below land surface requires a variance in accordance with 15A NCAC 2C.0118
 9. YIELD (gpm): 5 METHOD OF TEST Air
 10. WATER ZONES (depth): 1.00 gpm 90-91 4.00 gpm 370-372
0.00 gpm 0.00 gpm
 11. CHLORINATION: Type HTH Amount 73

12. CASING:

From	To	Depth	Diameter	Wall Thickness or Weight/Ft.	Material
0	50	Ft.	6 1/8	350	PVC
From	To	Ft.			
From	To	Ft.			

13. GROUT:

From	To	Depth	Material	Method
0	20	Ft.	Cement	Gravity Flow
From	To	Ft.		


14. SCREEN:

From	To	Depth	Diameter	Slot Size	Material
From	To	Ft.	in.	in.	
From	To	Ft.	in.	in.	
From	To	Ft.	in.	in.	

15. SAND/GRAVEL PACK:

From	To	Depth	Size	Material
From	To	Ft.		
From	To	Ft.		

16. REMARKS: _____
 I DO HEREBY CERTIFY THAT THIS WELL WAS CONSTRUCTED IN ACCORDANCE WITH 15A NCAC 2C, WELL CONSTRUCTION STANDARDS, AND THAT A COPY OF THIS RECORD HAS BEEN PROVIDED TO THE WELL OWNER.

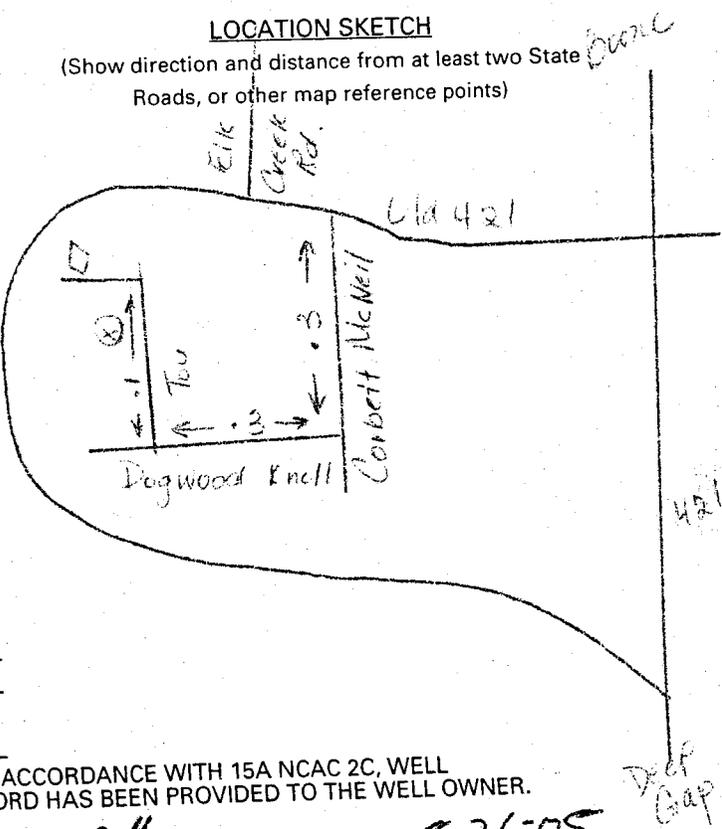

FOR OFFICE USE ONLY

Quad No: _____
 Serial No. _____

SIGNATURE OF PERSON CONSTRUCTING THE WELL: Steve Petty DATE: 5-26-05
 Submit original to Division of Water Quality, Groundwater Section within 30 days
 GW-1 REV. 12/99