

312141

WELL CONSTRUCTION RECORD

WELL CONTRACTOR: Dewey Wright Well Pump Co., Inc.
WELL CONTRACTOR CERTIFICATION #: 2681
STATE WELL CONSTRUCTION PERMIT#: Steve Petty

050186

1. WELL USE (Check Applicable Box): Residential Municipal Industrial Agricultural Monitoring
 Recovery Heat Pump Water Injection Other If Other, List Use: _____

2. WELL LOCATION: (Show sketch of the location below)
 Nearest Town: DEEP GAP County: WATAUGA
ELK CREEK RD
(Road Name and Numbers, Community, or Subdivision and Lot No.)

3. _____
4. DATE DRILLED 5/9/2005
5. TOTAL DEPTH 405
6. CUTTINGS COLLECTED YES NO
7. DOES WELL REPLACE EXISTING WELL? YES NO
8. STATIC WATER LEVEL Below Top of Casing: 50 FT.
(Use "+" if Above Top of Casing)

DRILLING LOG		DEPTH
From	To	Formation Description
0	65	DIRT
65	110	GRANITE
110	111	SHALE
111	378	GRANITE
378	405	GRANITE
	0	

REC'D BY CENTRAL FILES
JUN-2-05

If additional space is needed use back of form

9. TOP OF CASING IS 1 FT. Above Land Surface*
*Top of casing terminated at/or below land surface requires a variance in accordance with 15A NCAC 2C.0118
10. YIELD (gpm): 10 METHOD OF TEST Air
11. WATER ZONES (depth): 1.00 gpm 110-111 0.00 gpm 378-379
0.00 gpm 0.00 gpm
12. CHLORINATION: Type HTH Amount 71

13. CASING:

From	Depth	To	Diameter	Wall Thickness or Weight/Ft.	Material
0		70 Ft.	8 1/8	350	PVC

14. GROUT:

From	Depth	To	Material	Method
0		20 Ft.	Cement	Gravity Flow


15. SCREEN:

From	Depth	To	Ft.	Diameter	Slot Size	Material

16. SAND/GRAVEL PACK:

From	Depth	To	Ft.	Size	Material

17. REMARKS: _____
 I DO HEREBY CERTIFY THAT THIS WELL WAS CONSTRUCTED IN ACCORDANCE WITH 15A NCAC 2C, WELL CONSTRUCTION STANDARDS, AND THAT A COPY OF THIS RECORD HAS BEEN PROVIDED TO THE WELL OWNER.

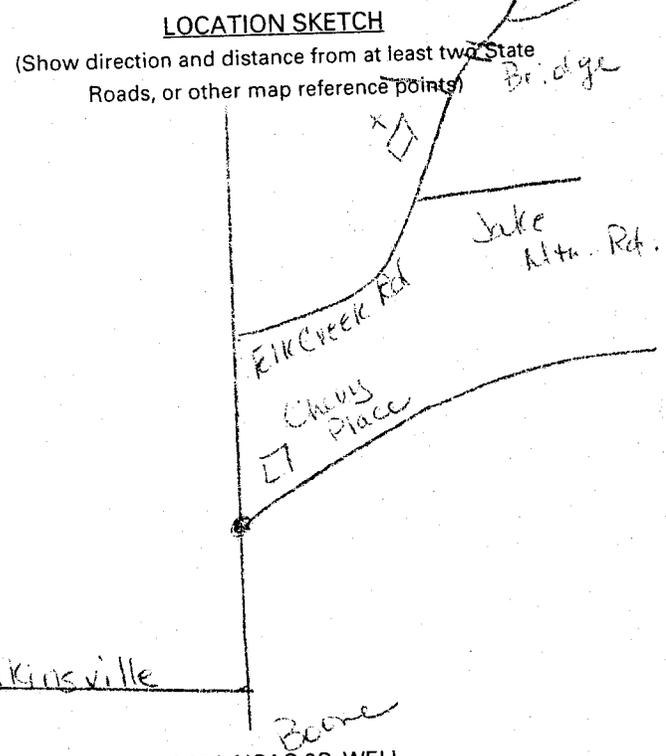

FOR OFFICE USE ONLY
 Quad No: _____
 Serial No: _____

SIGNATURE OF PERSON CONSTRUCTING THE WELL: Steve Petty DATE: 5-26-05
 Submit original to Division of Water Quality, Groundwater Section within 30 days
 GW-1 REV. 12/99