

WSKD

314658

**WELL CONSTRUCTION RECORD**

WELL CONTRACTOR: Dewey Wright Well Pump Co. Inc.  
 WELL CONTRACTOR CERTIFICATION #: 2878  
 STATE WELL CONSTRUCTION PERMIT#: Steve Price

050107

1. WELL USE (Check Applicable Box): Residential  Municipal  Industrial  Agricultural  Monitoring   
 Recovery  Heat Pump Water Injection  Other  If Other, List Use: \_\_\_\_\_

2. WELL LOCATION: (Show sketch of the location below)  
 Nearest Town: BLOWING ROCK County: WATAUGA  
TIPTON LN. OFF WONDERLAND RD. OFF GREENHILL R  
(Road Name and Numbers, Community, or Subdivision and Lot No.)

DRILLING LOG		DEPTH
From	To	Formation Description
0	54	DIRT
54	70	GRANITE
70	71	QUARTZ
71	80	GRANITE
80	91	QUARTZ
91	115	GRANITE
115	116	QUARTZ
116	125	GRANITE

3. \_\_\_\_\_
4. DATE DRILLED 5/26/2005
5. TOTAL DEPTH 125
6. CUTTINGS COLLECTED YES  NO
7. DOES WELL REPLACE EXISTING WELL? YES  NO
8. STATIC WATER LEVEL Below Top of Casing: 20 FT.  
(Use "+" if Above Top of Casing)


9. TOP OF CASING IS 1 FT. Above Land Surface\*  
\*Top of casing terminated at/or below land surface requires a variance in accordance with 15A NCAC 2C.0118
10. YIELD (gpm): 20 METHOD OF TEST Air
11. WATER ZONES (depth): 5.00 gpm 70-71 5.00 gpm 90-91  
10.00 gpm 115-116 0.00 gpm
12. CHLORINATION: Type HTH Amount 22

If additional space is needed use back of form

FILED BY CENTRAL FILE  
 JUN 28 2005

13. CASING:
- | From  | Depth | To        | Diameter | Wall Thickness or Weight/Ft. | Material |
|-------|-------|-----------|----------|------------------------------|----------|
| 0     |       | 55 Ft.    | 6 1/8    | 350                          | PVC      |
| _____ |       | _____ Ft. | _____    | _____                        | _____    |
| _____ |       | _____ Ft. | _____    | _____                        | _____    |

LOCATION SKETCH  
 (Show direction and distance from at least two State Roads, or other map reference points)

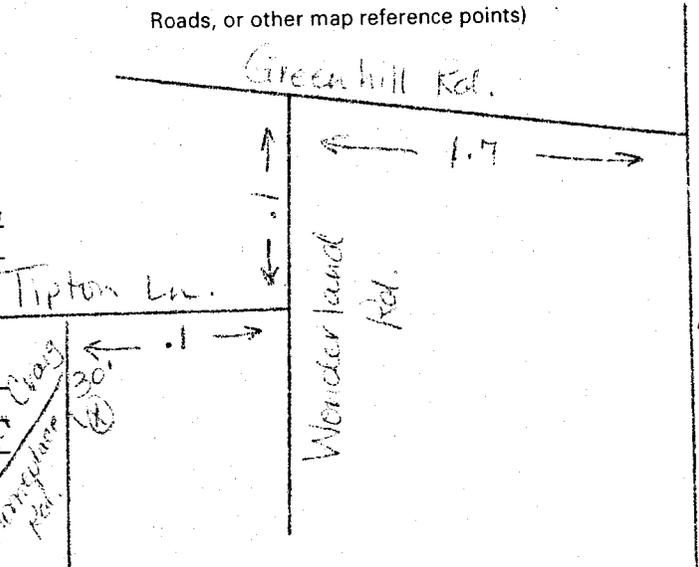

14. GROUT:
- | From  | Depth | To        | Material | Method       |
|-------|-------|-----------|----------|--------------|
| 0     |       | 20 Ft.    | Cement   | Gravity Flow |
| _____ |       | _____ Ft. | _____    | _____        |

15. SCREEN:
- | From  | Depth | To        | Diameter  | Slot Size | Material |
|-------|-------|-----------|-----------|-----------|----------|
| _____ | _____ | _____ Ft. | _____ in. | _____ in. | _____    |
| _____ | _____ | _____ Ft. | _____ in. | _____ in. | _____    |
| _____ | _____ | _____ Ft. | _____ in. | _____ in. | _____    |

16. SAND/GRAVEL PACK:
- | From  | Depth | To        | Size  | Material |
|-------|-------|-----------|-------|----------|
| _____ | _____ | _____ Ft. | _____ | _____    |
| _____ | _____ | _____ Ft. | _____ | _____    |

17. REMARKS: \_\_\_\_\_

I DO HEREBY CERTIFY THAT THIS WELL WAS CONSTRUCTED IN ACCORDANCE WITH 15A NCAC 2C, WELL CONSTRUCTION STANDARDS, AND THAT A COPY OF THIS RECORD HAS BEEN PROVIDED TO THE WELL OWNER.

Steven Price 6-10-05

FOR OFFICE USE ONLY  
 Quad No: \_\_\_\_\_  
 \_\_\_\_\_

SIGNATURE OF PERSON CONSTRUCTING THE WELL  
 Submit original to Division of Water Quality, Groundwater Section within 30 days

DATE  
 GW-1 REV. 12/99