

WS
 314668

WELL CONSTRUCTION RECORD

WELL CONTRACTOR: Dewey Wright Well Pump Co., Inc.
 WELL CONTRACTOR CERTIFICATION #: 2686
 STATE WELL CONSTRUCTION PERMIT#: Leslie Reece

050216

1. WELL USE (Check Applicable Box): Residential Municipal Industrial Agricultural Monitoring
 Recovery Heat Pump Water Injection Other If Other, List Use: _____

2. WELL LOCATION: (Show sketch of the location below)
 Nearest Town: BOONE County: WATAUGA
MARLOWE RD. OFF BROADSTONE RD. OFF 105
(Road Name and Numbers, Community, or Subdivision and Lot No.)

3. _____
 4. DATE DRILLED 5/23/2005
 5. TOTAL DEPTH 280
 6. CUTTINGS COLLECTED YES NO
 7. DOES WELL REPLACE EXISTING WELL? YES NO
 8. STATIC WATER LEVEL Below Top of Casing: 50 FT.
(Use "+" if Above Top of Casing)

DRILLING LOG		DEPTH
From	To	Formation/Description
0	57	DIRT
57	210	GRANITE
210	211	SHALE
211	240	GRANITE
240	242	SHALE
242	280	GRANITE

RECORDED BY CENTRAL FILES
JUL 28 2005

9. TOP OF CASING IS 1 FT. Above Land Surface*
*Top of casing terminated at/or below land surface requires a variance in accordance with 15A NCAC 2C.0118
 10. YIELD (gpm): 25 METHOD OF TEST Air
 11. WATER ZONES (depth): 10.00 gpm 210-211 15.00 gpm 240-242
0.00 gpm 0.00 gpm
 12. CHLORINATION: Type HTH Amount 44

If additional space is needed use back of form.

13. CASING:

From	To	Depth	Diameter	Wall Thickness or Weight/Ft.	Material
0	53 Ft.	53 Ft.	6 1/8"	350	PVC
_____	_____	_____	_____	_____	_____
_____	_____	_____	_____	_____	_____

14. GROUT:

From	To	Depth	Material	Method
0	20	20	Cement	Gravity Flow
_____	_____	_____	_____	_____


15. SCREEN:

From	To	Depth	Diameter	Slot Size	Material
_____	_____	_____	_____	_____	_____
_____	_____	_____	_____	_____	_____
_____	_____	_____	_____	_____	_____

16. SAND/GRAVEL PACK:

From	To	Depth	Size	Material
_____	_____	_____	_____	_____
_____	_____	_____	_____	_____

17. REMARKS: _____
 I DO HEREBY CERTIFY THAT THIS WELL WAS CONSTRUCTED IN ACCORDANCE WITH 15A NCAC 2C, WELL CONSTRUCTION STANDARDS, AND THAT A COPY OF THIS RECORD HAS BEEN PROVIDED TO THE WELL OWNER.

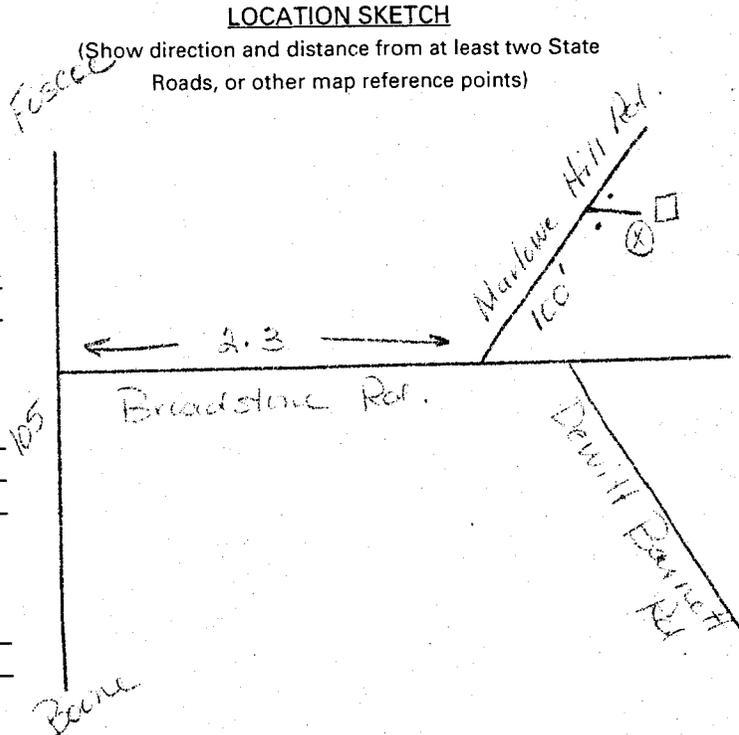

Wayne Reece 6-15-05
 SIGNATURE OF PERSON CONSTRUCTING THE WELL DATE

Submit original to Division of Water Quality, Groundwater Section within 30 days
 GW-1 REV. 12/99

FOR OFFICE USE ONLY
 Quad No: _____
 Serial No: _____