

WS

315326

WELL CONSTRUCTION RECORD

050192

WELL CONTRACTOR: Dewey Wright Well Pump Co., Inc.
 WELL CONTRACTOR CERTIFICATION #: 2978
 STATE WELL CONSTRUCTION PERMIT#: Steve Price

1. WELL USE (Check Applicable Box): Residential Municipal Industrial Agricultural Monitoring
 Recovery Heat Pump Water Injection Other If Other, List Use: _____

2. WELL LOCATION: (Show sketch of the location below)
 Nearest Town: SILVERSTONE County: WATAUGA
KELLERSVILLE RD OFF 321
(Road Name and Numbers, Community, or Subdivision and Lot No.)

3. DATE DRILLED 7/23/2005
 4. TOTAL DEPTH 205
 6. CUTTINGS COLLECTED YES NO
 7. DOES WELL REPLACE EXISTING WELL? YES NO
 8. STATIC WATER LEVEL Below Top of Casing: 30 FT.
(Use "+" if Above Top of Casing)

DRILLING LOG		DEPTH
From	To	Formation Description
0	17	DIRT
17	130	GRANITE
130	131	GRANITE
131	150	GRANITE
150	151	RED GRANITE
151	192	GRANITE
192	193	RED GRANITE
193	205	GRANITE

RECEIVED
 AUG 22 2005
 DIVISION OF WATER QUALITY


If additional space is needed use back of form

9. TOP OF CASING IS 1 FT. Above Land Surface*
*Top of casing terminated at/or below land surface requires a variance in accordance with 15A NCAC 2C.0118
 10. YIELD (gpm): 7 METHOD OF TEST Air
 11. WATER ZONES (depth): 1.00 gpm 130-131 1.00 gpm 150-151
5.00 gpm 192-193 0.00 gpm
 12. CHLORINATION: Type HTH Amount 36

13. CASING:

From	Depth	To	Diameter	Wall Thickness or Weight/Ft.	Material
0	0	23	8 1/8	350	PVC
From	To	Ft.			
From	To	Ft.			

LOCATION SKETCH
 (Show direction and distance from at least two State Roads, or other map reference points)

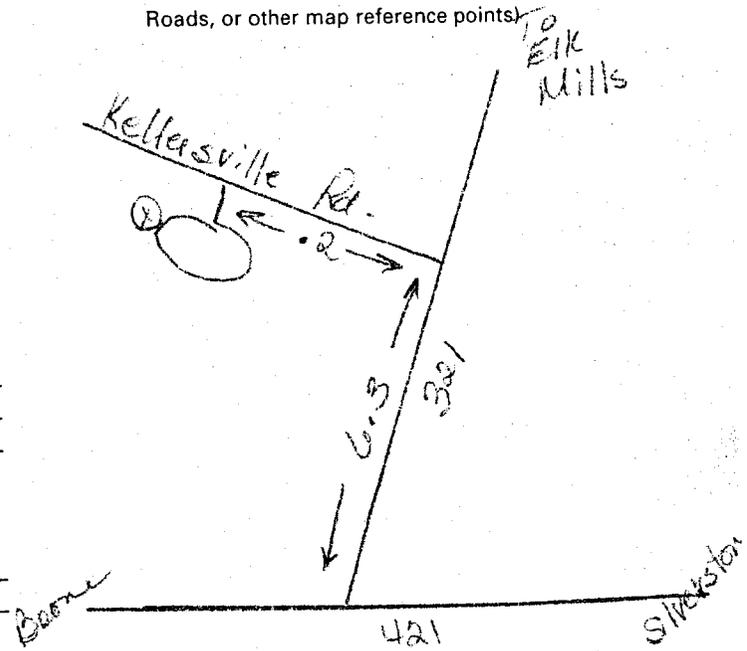

14. GROUT:

From	Depth	To	Material	Method
0	0	20	Cement	Gravity Flow
From	To	Ft.		

15. SCREEN:

From	Depth	To	Diameter	Slot Size	Material
From	To	Ft.	in.	in.	
From	To	Ft.	in.	in.	
From	To	Ft.	in.	in.	

16. SAND/GRAVEL PACK:

From	Depth	To	Size	Material
From	To	Ft.		
From	To	Ft.		

17. REMARKS: _____
 I DO HEREBY CERTIFY THAT THIS WELL WAS CONSTRUCTED IN ACCORDANCE WITH 15A NCAC 2C, WELL CONSTRUCTION STANDARDS, AND THAT A COPY OF THIS RECORD HAS BEEN PROVIDED TO THE WELL OWNER.

Steve Price SIGNATURE OF PERSON CONSTRUCTING THE WELL
8-10-05 DATE

FOR OFFICE USE ONLY
 Quad No: _____