

W7

315327

WELL CONSTRUCTION RECORD

WELL CONTRACTOR: Dewey Wright Well Pump Co., Inc.
 WELL CONTRACTOR CERTIFICATION #: 2878
 STATE WELL CONSTRUCTION PERMIT#: Steve Price

050385

1. WELL USE (Check Applicable Box): Residential Municipal Industrial Agricultural Monitoring
 Recovery Heat Pump Water Injection Other If Other, List Use: _____

2. WELL LOCATION: (Show sketch of the location below)
 Nearest Town: BOONE County: WATAUGA
LOT # 3 OFF BEAVER DAM RD. OFF BETHEL RD. OFF 3
(Road Name and Numbers, Community, or Subdivision and Lot No.)

3. DRILLING LOG

From	To	DEPTH	Formation Description
0	44		DIRT
44	140		GRANITE
140	142		RED GRANITE
142	155		GRANITE
155	157		RED GRANITE
157	185		GRANITE

4. DATE DRILLED 7/28/2005
 5. TOTAL DEPTH 185
 6. CUTTINGS COLLECTED YES NO
 7. DOES WELL REPLACE EXISTING WELL? YES NO
 8. STATIC WATER LEVEL Below Top of Casing: 20 FT.
(Use "+" if Above Top of Casing)

9. TOP OF CASING IS 1 FT. Above Land Surface*
*Top of casing terminated at/or below land surface requires a variance in accordance with 15A NCAC 2C.0118
 10. YIELD (gpm): 30 METHOD OF TEST Air
 11. WATER ZONES (depth): 3.00 gpm 140-142 27.00 gpm 155-157
0.00 gpm 0.00 gpm
 12. CHLORINATION: Type HTH Amount 30

From	To	DEPTH	Formation Description
0	44		DIRT
44	140		GRANITE
140	142		RED GRANITE
142	155		GRANITE
155	157		RED GRANITE
157	185		GRANITE

AUG 22 2005
 NOT RECORDED
 DIVISION OF WATER QUALITY

If additional space is needed use back of form

13. CASING:

From	Depth	To	Diameter	Wall Thickness or Weight/Ft.	Material
0		50 Ft.	6 1/8	350	PVC
From	To	Ft.			
From	To	Ft.			

LOCATION SKETCH
 (Show direction and distance from at least two State Roads, or other map reference points)

14. GROUT:

From	Depth	To	Material	Method
0		20 Ft.	Cement	Gravity Flow
From	To	Ft.		


15. SCREEN:

From	Depth	To	Diameter	Slot Size	Material
From	To	Ft.	in.	in.	
From	To	Ft.	in.	in.	
From	To	Ft.	in.	in.	

16. SAND/GRAVEL PACK:

From	Depth	To	Size	Material
From	To	Ft.		
From	To	Ft.		

17. REMARKS:

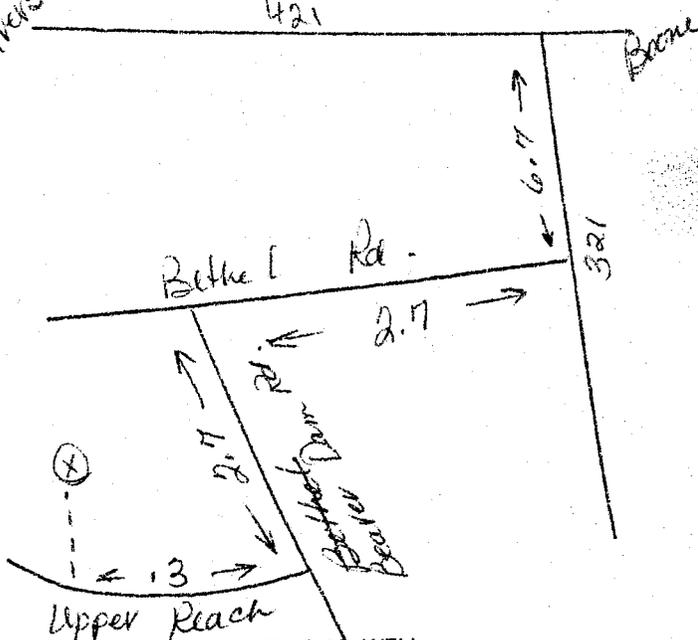

I DO HEREBY CERTIFY THAT THIS WELL WAS CONSTRUCTED IN ACCORDANCE WITH 15A NCAC 2C.0118 WELL CONSTRUCTION STANDARDS, AND THAT A COPY OF THIS RECORD HAS BEEN PROVIDED TO THE WELL OWNER.

Steven Price 8-10-05
 SIGNATURE OF PERSON CONSTRUCTING THE WELL DATE

Submit original to Division of Water Quality, Groundwater Section within 30 days GW-1 REV. 12/99

FOR OFFICE USE ONLY
 Quad No: _____
 Serial No. _____