

WS

315329

WELL CONSTRUCTION RECORD

WELL CONTRACTOR: Dewey Wright Well Pump Co., Inc.
 WELL CONTRACTOR CERTIFICATION #: 2878
 STATE WELL CONSTRUCTION PERMIT#: Steve Price

050364

1. WELL USE (Check Applicable Box): Residential Municipal Industrial Agricultural Monitoring
 Recovery Heat Pump Water Injection Other If Other, List Use: _____

2. WELL LOCATION: (Show sketch of the location below)
 Nearest Town: BOONE County: WATAUGA
LOT # 2 OFF UPPER REACH OFF BEAVER DAM RD. OFF
(Road Name and Numbers, Community, or Subdivision and Lot No.)

3. DRILLING LOG

From	To	DEPTH
0	119	DIRT
119	380	GRANITE
380	382	RED GRANITE
382	405	GRANITE

4. DATE DRILLED 7/27/2005
 5. TOTAL DEPTH 405
 6. CUTTINGS COLLECTED YES NO
 7. DOES WELL REPLACE EXISTING WELL? YES NO
 8. STATIC WATER LEVEL Below Top of Casing: 50 FT.
(Use "+" if Above Top of Casing)

9. TOP OF CASING IS 1 FT. Above Land Surface*
*Top of casing terminated at/or below land surface requires a variance in accordance with 15A NCAC 2C.0118
 10. YIELD (gpm): 15 METHOD OF TEST Air
 11. WATER ZONES (depth): 15.00 gpm 380-382 0.00 gpm
0.00 gpm 0.00 gpm
 12. CHLORINATION: Type HTH Amount 71


FORMATION DESCRIPTION

From	To	DEPTH
0	119	DIRT
119	380	GRANITE
380	382	RED GRANITE
382	405	GRANITE

If additional space is needed use back of form

13. CASING:

From	Depth	To	Diameter	Wall Thickness or Weight/Ft.	Material
0	0	125 Ft.	6 1/8	350	PVC
From	To	Ft.			
From	To	Ft.			

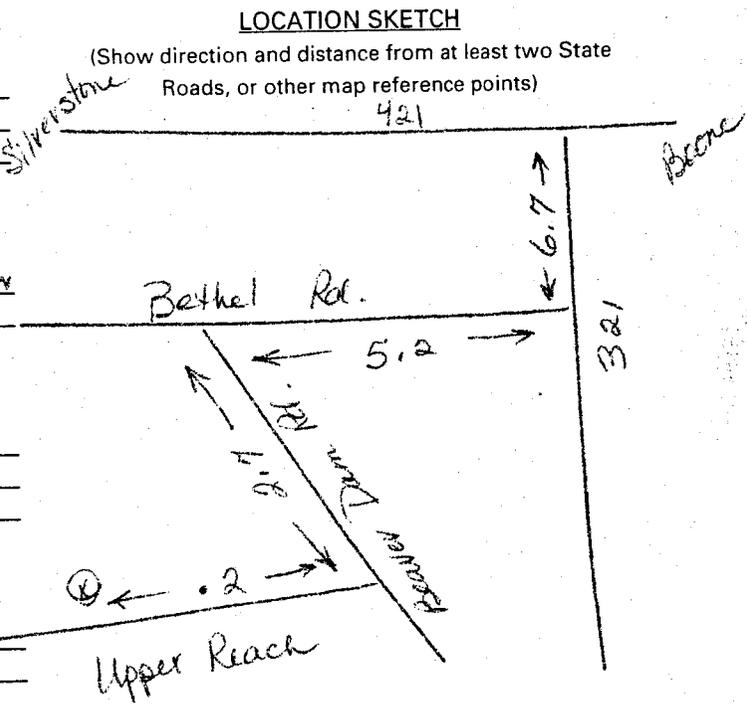

14. GROUT:

From	Depth	To	Material	Method
0	0	20 Ft.	Cement	Gravity Flow
From	To	Ft.		

15. SCREEN:

From	Depth	To	Ft.	Diameter	Slot Size	Material
From	To	Ft.				
From	To	Ft.				
From	To	Ft.				

16. SAND/GRAVEL PACK:

From	Depth	To	Ft.	Size	Material
From	To	Ft.			
From	To	Ft.			

17. REMARKS: I DO HEREBY CERTIFY THAT THIS WELL WAS CONSTRUCTED IN ACCORDANCE WITH 15A NCAC 2C, WELL CONSTRUCTION STANDARDS, AND THAT A COPY OF THIS RECORD HAS BEEN PROVIDED TO THE WELL OWNER.

Steve Price SIGNATURE OF PERSON CONSTRUCTING THE WELL DATE 8-10-05

FOR OFFICE USE ONLY
 Quad No: _____