

WS

815330

WELL CONSTRUCTION RECORD

WELL CONTRACTOR: Dewey Wright Well Pump Co., Inc.
 WELL CONTRACTOR CERTIFICATION #: 2878
 STATE WELL CONSTRUCTION PERMIT#: Steve Price

050342

1. WELL USE (Check Applicable Box): Residential Municipal Industrial Agricultural Monitoring
 Recovery Heat Pump Water Injection Other If Other, List Use: _____

2. WELL LOCATION: (Show sketch of the location below)
 Nearest Town: BOONE County: WATAUGA
MTN DALE RD. OFF BETHEL RD. OFF 321 OFF 421
(Road Name and Numbers, Community, or Subdivision and Lot No.)

3. DATE DRILLED 7/28/2005
 4. TOTAL DEPTH 205
 5. CUTTINGS COLLECTED YES NO
 6. DOES WELL REPLACE EXISTING WELL? YES NO
 7. STATIC WATER LEVEL Below Top of Casing: 30 FT.
(Use "+" if Above Top of Casing)

DRILLING LOG		DEPTH
From	To	Formation Description
0	34	DIRT
34	130	GRANITE
130	131	GRANITE
131	178	GRANITE
178	180	RED GRANITE
180	205	GRANITE

RECD BY OFFICIAL
 AUG 22 05

9. TOP OF CASING IS 1 FT. Above Land Surface*
*Top of casing terminated at/or below land surface requires a variance in accordance with 15A NCAC 2C.0118
 10. YIELD (gpm): 30 METHOD OF TEST Air
 11. WATER ZONES (depth): 2.00 gpm 130-131 28.00 gpm 178-180
0.00 gpm 0.00 gpm
 12. CHLORINATION: Type HTH Amount 36

If additional space is needed use back of form

13. CASING:

From	Depth	Diameter	Wall Thickness or Weight/Ft.	Material
0	To 100 Ft.	6 1/8	350	PVC
From	To	Ft.		
From	To	Ft.		

14. GROUT:


From	Depth	Material	Method
0	To 20 Ft.	Cement	Gravity Flow
From	To	Ft.	

15. SCREEN:

From	Depth	Diameter	Slot Size	Material
From	To	Ft.	in.	in.
From	To	Ft.	in.	in.
From	To	Ft.	in.	in.

16. SAND/GRAVEL PACK:

From	Depth	Size	Material
From	To	Ft.	
From	To	Ft.	

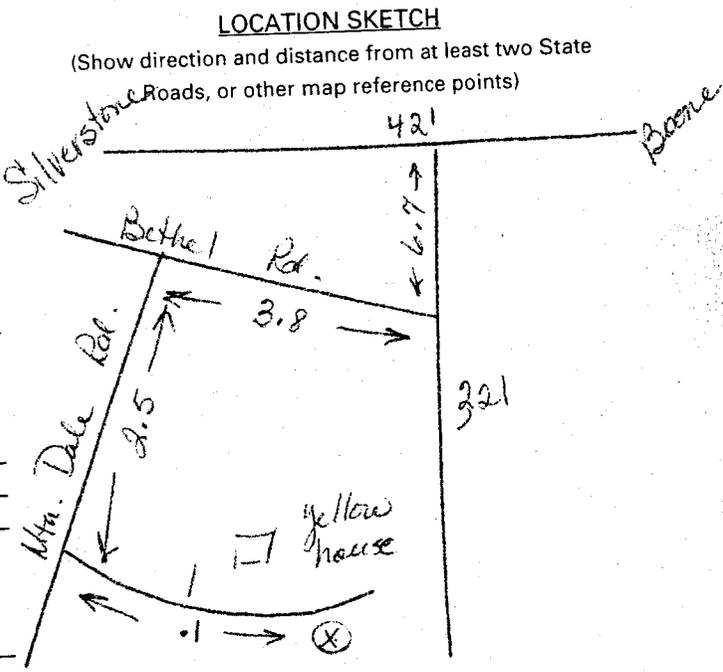

17. REMARKS: _____
 I DO HEREBY CERTIFY THAT THIS WELL WAS CONSTRUCTED IN ACCORDANCE WITH 15A NCAC 2C, WELL CONSTRUCTION STANDARDS, AND THAT A COPY OF THIS RECORD HAS BEEN PROVIDED TO THE WELL OWNER.
Steve Price 9-10-05
 SIGNATURE OF PERSON CONSTRUCTING THE WELL DATE
 Submit original to Division of Water Quality, Groundwater Section within 30 days
 GW-1 REV. 12/99

FOR OFFICE USE ONLY
 Quad No: _____