

WS

315334

WELL CONSTRUCTION RECORD

WELL CONTRACTOR: Dewey Wright Well Pump Co., Inc.
 WELL CONTRACTOR CERTIFICATION #: 2878
 STATE WELL CONSTRUCTION PERMIT#: Steve Price

050334

1. WELL USE (Check Applicable Box): Residential Municipal Industrial Agricultural Monitoring
 Recovery Heat Pump Water Injection Other If Other, List Use: _____

2. WELL LOCATION: (Show sketch of the location below)
 Nearest Town: BLOWING ROCK County: WATAUGA
CAMDEN LANE OFF KNOB RD. OFF HWY 221 OFF HWY
(Road Name and Numbers, Community, or Subdivision and Lot No.)

DRILLING LOG

DEPTH

From	To	Formation Description
0	19	DIRT
19	60	GRANITE
60	62	QUARTZ
62	130	GRANITE
130	133	QUARTZ
133	145	GRANITE

3. DATE DRILLED 7/21/2005
 4. TOTAL DEPTH 145
 6. CUTTINGS COLLECTED YES NO
 7. DOES WELL REPLACE EXISTING WELL? YES NO
 8. STATIC WATER LEVEL Below Top of Casing: 20 FT.
(Use "+" if Above Top of Casing)

9. TOP OF CASING IS 1 FT. Above Land Surface*
*Top of casing terminated at/or below land surface requires a variance in accordance with 15A NCAC 2C.0118
 10. YIELD (gpm): 50 METHOD OF TEST Air
 11. WATER ZONES (depth): 1.00 gpm 60-62 49.00 gpm 130-133
0.00 gpm 0.00 gpm
 12. CHLORINATION: Type HTH Amount 28

If additional space is needed use back of form


REC'D BY CATHY M. HUBB
AUG 22 2005

13. CASING:

From	To	Depth	Diameter	Wall Thickness or Weight/Ft.	Material
0	25	Ft.	6 1/8	350	PVC
From	To	Ft.			
From	To	Ft.			

LOCATION SKETCH

Show direction and distance from at least two State Roads, or other map reference points)

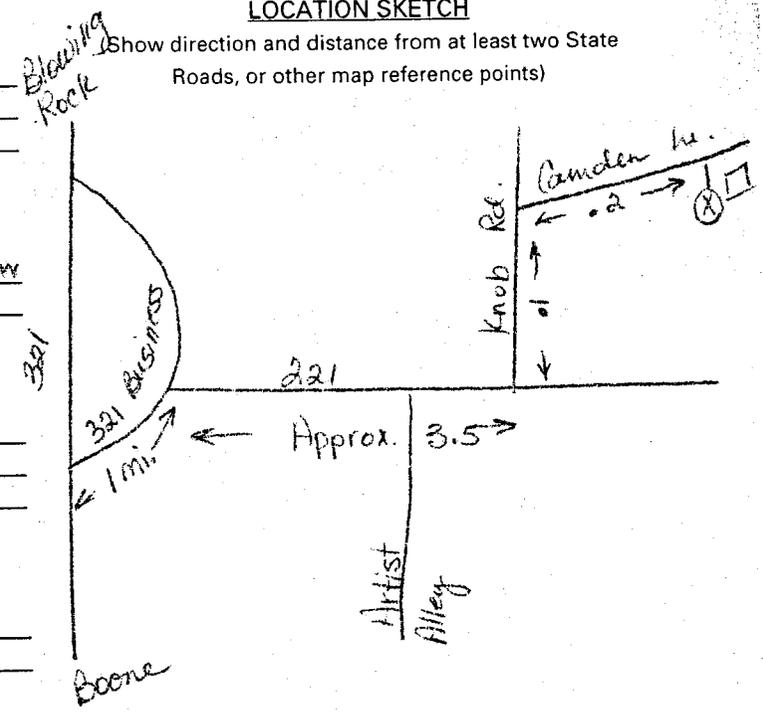

14. GROUT:

From	To	Depth	Material	Method
0	20	Ft.	Cement	Gravity Flow
From	To	Ft.		

15. SCREEN:

From	To	Depth	Diameter	Slot Size	Material
From	To	Ft.	in.	in.	
From	To	Ft.	in.	in.	
From	To	Ft.	in.	in.	

16. SAND/GRAVEL PACK:

From	To	Depth	Size	Material
From	To	Ft.		
From	To	Ft.		

17. REMARKS:
 I DO HEREBY CERTIFY THAT THIS WELL WAS CONSTRUCTED IN ACCORDANCE WITH 15A NCAC 2C, WELL CONSTRUCTION STANDARDS, AND THAT A COPY OF THIS RECORD HAS BEEN PROVIDED TO THE WELL OWNER.
Steven Price 8-10-05
 SIGNATURE OF PERSON CONSTRUCTING THE WELL DATE

FOR OFFICE USE ONLY
 Quad No: _____